

74-96

Trigonometrical Survey of N.S.W.

Dept. of Main Roads

RECONNAISSANCE and MAINTENANCE REPORT

STATION COREIN303

TS 1644

This Trig. Station has been:-

Note: Cross out word or words which do not apply

Co: Wynyard Ph: Tywong  
 Map Sheet: Tarcutta No: 8427  
 Inspected by: G.B. Mebberson Date: 21.10.75  
 Authority: Dept. of Main Roads Field Book:

1. Completely cleared to permit 360° vision to surrounding Trigs.

2. ~~Cleared by lanes bearing~~ from Trig. Mast

3. ~~Trig. Mast & Vanes have been painted white & black respectively~~

4. The Trig. was ~~unpiled~~ / not unpiled, dimensions now being:

Description of mark..... N.K...... should be explicit, e.g. Steel plug, Brass plug, Bolt, G.I. Pipe

Height of mark..... N.K...... m <sup>above</sup> / <sub>below</sub> rock/concrete ..... N.K...... m <sup>above</sup> / <sub>below</sub> G.L.

Height of Top Vanes to Top Mark..... N.K...... m. Diameter of Vanes (vertical)..... 0.92..... m.

Height of Cairn..... 1.2..... m. Diameter of Cairn..... N.K...... m.

Length of Mast..... 3.2..... m. (approximate if not unpiled)

5. A..... set in conc/rock has been placed..... m. bearing..... °M from Trig. Mast

6. A..... set in conc/soil has been placed..... m. bearing..... °M from Trig. Mast

7. A..... set in conc/soil has been placed..... m. bearing..... °M from Trig. Mast

8. A..... set in conc/rock has been placed..... m. bearing..... °M from Trig. Mast

9. Connection..... to..... :..... m. bearing..... °M

10. Connection..... to..... :..... m. bearing..... °M

11. Connection..... to..... :..... m. bearing..... °M

12. Connection..... to..... :..... m. bearing..... °M

13. Diff. Ht. .... is..... m. <sup>above</sup> / <sub>below</sub>

14. Diff. Ht. .... is..... m. <sup>above</sup> / <sub>below</sub>

15. Diff. Ht. .... is..... m. <sup>above</sup> / <sub>below</sub>

16. Diff. Ht. .... is..... m. <sup>above</sup> / <sub>below</sub>


Prepared by:

Checked:

Noted on U.T.M. Card

Checked

Beacon Diagram Not to Scale

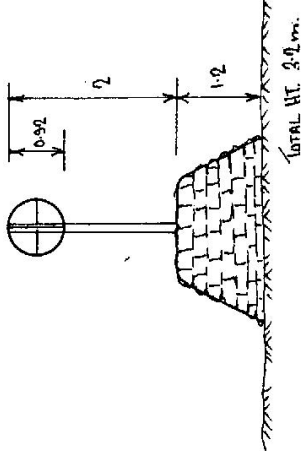

Date

Record of Station

