

CENTRAL MAPPING AUTHORITY

GEODETIC SURVEY OF M.S.W.

GEODETIC STATION RECONNAISSANCE and MAINTENANCE REPORT

STATION: **CORELLA G.S.** No.: **1645**

MAP SHEET SCALE 1:250 000 **NARROMINE**

INSPECTED BY: **R. COOK** DATE: **SEPT 1978**

AUTHORITY: **C.M.A.** FIELD BOOK:

Description: *Note: Cross out word or words which do not apply*

1. Cleared by lanes bearing..... from Trig. Mast
2. Mast & Vanes have been painted white & black respectively.
3. The station/pillar ~~was constructed~~/not unplied/constructed on.....19....., dimensions now being: Description of mark.....*S.P.D.*.....should be explicit. e.g., S/Steel Pillar Plate, Steel plug, Brass plug, Bolt, G.I. Pipe Height of mark.....*3.60*.....m. ^{above} below rock/concrete; Mark is.....*3.60*.....m. ^{above} below G.L.
- Height of Top Vanes to Top Mark/Pillar platem. Diameter of Vanes (vertical).....*0.02*.....m.
- Height of Cairn.....*1.70*.....m. Diameter of Cairn.....*3.40*.....m. Name Plate found/not found/placed.
- Length of Mast*3.60*.....m. (approximate if not unplied)
4. A.....*3.60*.....set in conc/rock has been placed/found, bearing.....° M from Mast/Plug/Pillar
5. A.....*3.60*.....set in conc/rock has been placed/found, bearing.....° M from Mast/Plug/Pillar
6. A.....*3.60*.....set in conc/rock has been placed/found, bearing.....° M from Mast/Plug/Pillar
7. A.....*3.60*.....set in conc/rock has been placed/found, bearing.....° M from Mast/Plug/Pillar
8. Action required: *As per page 2. P. says clearing needed NOT suitable for pillar.*

STANDPOINT:


Mark	Direction	Horiz. Distance	Height Difference	Mark	Direction	Horiz. Distance	Height Difference
			above below standpt.				above below standpt.
			above below standpt.				above below standpt.
Prepared by: **R. COOK**

Checked: *[Signature]*

Checked: *[Signature]*


Note: on U.T.M. Card

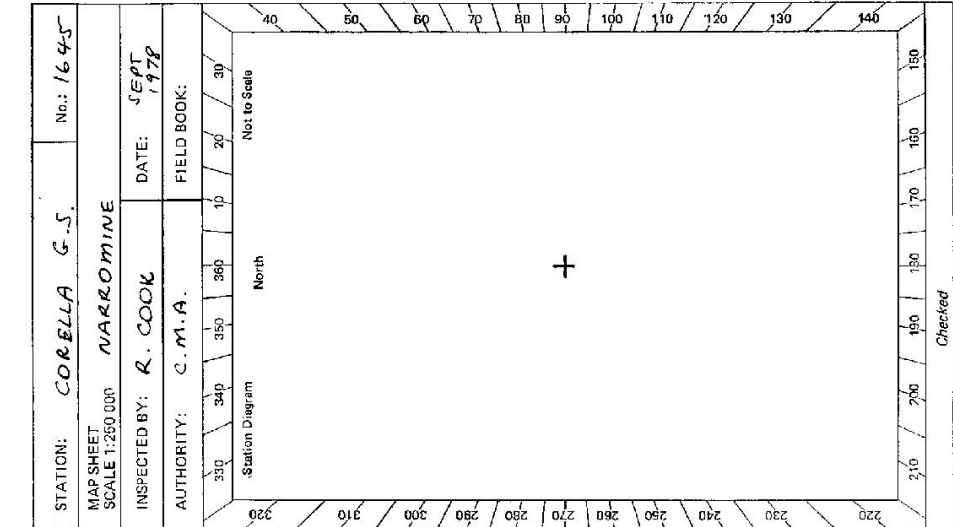

STATION **CORELLA** **G.S.** ^{TS} **1645**

Owner's Name:
 Address:
 Phone:
 Current Occupant:
 Address:
 Phone:

Address Report of **sept 1978** /19..... was found suitable/unavailable.
ACCESS
10 minute walk from the base of the Hill. Access found on the Boona 1:50,000 sheet

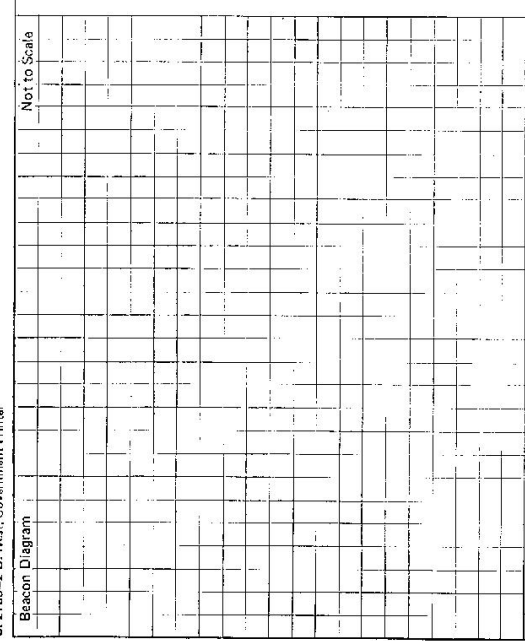

This section to be completed by officer constructing pillar.
 Original station mark found/not found.
 Description of mark:
 Original beacon found/not found.
 Description of ascent:
 Height: Top of Vanes to Top Markm.
 Height of markm. above G.L.
 belowm.
 Diameter of Vanesm. Height of Cairnm.
 Original Beacon has/has not been destroyed by me.

Date **Sept 1978** Record of Station **STATION VISITED IN CONNECTION WITH FIELD COMPLETION**