

CENTRAL MAPPING AUTHORITY

GEODETIC SURVEY OF N.S.W.

GEODETIC STATION RECONNAISSANCE and MAINTENANCE REPORT

Description:

1. Cleared by lances bearing..... Heavy Timber <sup>10 Mag</sup> from Trig. Mast  
*Note: Cross out word or words which do not apply*
2. Mast & Vanes have been painted white & black respectively.
3. The station/~~pillar~~ <sup>was supplied/not unpiled/constructed</sup> on 2.4.11.19.7.8., dimensions now being:  
Description of mark.....should be explicit, e.g., S/Steel Pillar Plate, Steel plug, Brass plug, Bolt, G.I. Pipe  
Height of mark.....m. <sup>above</sup> rock/concrete; Mark is.....m. <sup>above</sup> G.L.
- Height of Top Vanes to Top Mark/Pillar plate.....m. Diameter of Vanes (vertical).....m.
- Height of Cairn.....1.8 m. Diameter of Cairn.....2 m. Name Plate found/not found/placed.
- Length of Mast.....4.2 m. (approximate if not unpiled)
4. A.....set in conc/rock has been placed/found, bearing.....° M from Mast/Plug/Pillar
5. A.....set in conc/rock has been placed/found, bearing.....° M from Mast/Plug/Pillar
6. A.....set in conc/rock has been placed/found, bearing.....° M from Mast/Plug/Pillar
7. A.....set in conc/rock has been placed/found, bearing.....° M from Mast/Plug/Pillar
8. Action required:.....

STANDPOINT:

STANDPOINT:

| Mark | Direction | Horiz. Distance | Height Difference | Mark | Direction | Horiz. Distance | Height Difference |
|------|-----------|-----------------|-------------------|------|-----------|-----------------|-------------------|
|      |           |                 | above standpt.    |      |           |                 | above standpt.    |
|      |           |                 | below             |      |           |                 | below             |
|      |           |                 | above standpt.    |      |           |                 | above standpt.    |
|      |           |                 | below             |      |           |                 | below             |
Prepared by: W.M.

Checked: 4.8.12.28

Noted on U.T.M. Card

SI 2783-1

STATION: **CORNER** TS No.: **1650**

MAP SHEET SCALE 1:250 000 **CAMBERRA**

INSPECTED BY: **W MILLER** DATE: **24.11.78**

AUTHORITY: **CMA** FIELD BOOK:


Station Diagram

+

North

Not to Scale

Checked

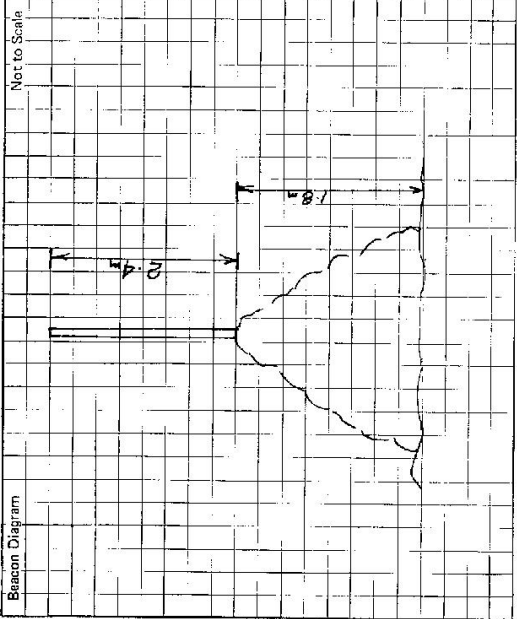

Owner's Name: .....  
 Address: .....  
 Phone: .....  
 Current Occupant: .....  
 Address: .....  
 Phone: .....

ACCESS  
 Access Report of 24.11.19. It was found suitable/unsuitable.

At Quinceyan take road to Braidwood and Bungeoore.  
 Just out of Quinceyan take road to Captain's Flat (Signpost)  
 Travel approx 20km and take dirt track on the right Wickham Lane.  
 Travel approx 12 km - you will notice a large shed on the hill  
 on the left hand side approx 200 m off the road.  
 You will now pass through a gate on the main road.  
 200 m past the gate take the track on the right hand side  
 Follow the track for 800m until you reach a dam on the  
 left hand side. Go past the dam and follow the tree  
 line to the left.  
 There is a gap in the trees which leads to the  
 top of the Hill.

This section to be completed by officer constructing pillar.

Original station mark found/not found.  
 Description of mark: .....  
 Original beacon found/not found.  
 Description of beacon: .....  
 Height Top of Vanes to Top Mark.....m.  
 Height of mark.....m. above G.L. below G.L.  
 Diameter of Vanes.....m. Height of Cairn.....m.  
 Original Beacon has/not been destroyed by me.

| Date     | Record of Station |
|----------|-------------------|
| 24.11.19 | Station Visited   |
|          |                   |
|          |                   |
|          |                   |