

CENTRAL MAPPING AUTHORITY  
GEODETTIC SURVEY OF A.S.H.

GEODETTIC STATION RECONNAISSANCE and MAINTENANCE REPORT


STATION: COTTON No.: 1663

MAP SHEETS SCALE 1:250 000 FORBES  
SCALE 1:100 000  
INSPECTED BY: J. Judg  
DATE: 30.5.85  
AUTHORITY: CMA  
FIELD BOOK:

- Description:  
 Note: Cross out word or words which do not apply  
 1. Cleared by lanes bearing..... This is on timbered hill  
 2. Mast & Vanes have been painted white & black respectively. Stone cairn only  
 3. The station/pillar was unpiled/not unpiled/constructed on..... 19....., dimensions now being:

- Description of mark..... should be explicit, e.g., S/Steel Pillar Plate, Steel plug, Brass plug, Bolt, G.I. Pipe  
 Height of mark..... m. above below rock/concrete; Mark is..... m. above below G.L.  
 Height of Top Vanes to Top Mark/Pillar plate..... m. Diameter of Vanes (vertical)..... m.  
 Height of Cairn..... m. Diameter of Cairn..... m. Name Plate found/not found/placed.  
 Length of Mast..... m. (approximate if not unpiled)
4. A..... set in conc/rock has been placed/ found, bearing.....°M from Mast/Plug/Pillar  
 5. A..... set in conc/rock has been placed/ found, bearing.....°M from Mast/Plug/Pillar  
 6. A..... set in conc/rock has been placed/ found, bearing.....°M from Mast/Plug/Pillar  
 7. A..... set in conc/rock has been placed/ found, bearing.....°M from Mast/Plug/Pillar

8. Action required:.....

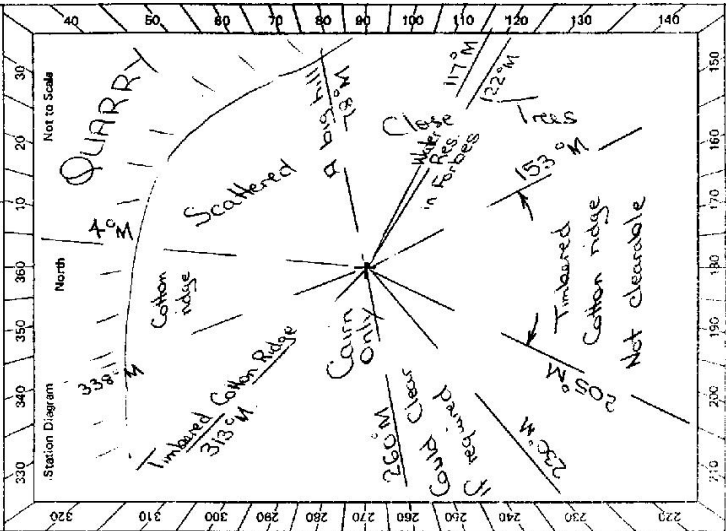

STANDPOINT:

Mark	Direction	Horiz. Distance	Height Difference	Mark	Direction	Horiz. Distance	Height Difference
			above standpt.				below standpt.
			below standpt.				above standpt.
			above standpt.				below standpt.
			below standpt.				above standpt.
			above standpt.				below standpt.
			below standpt.				above standpt.
			above standpt.				below standpt.
			below standpt.				above standpt.


Prepared by: J. Judg  
Checked: [Signature]

Named on U.T.M. Grid



S.O. 1407

GS 24

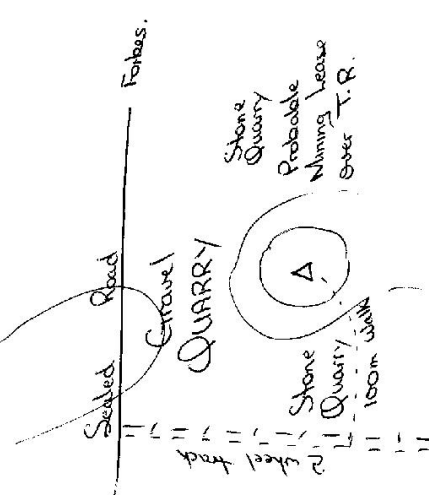STATION	COTTON IS-1663	
Owner's Name		Current Occupant
Address		Address
Phone		Phone
<b>ACCESS:</b>		
Access Report of 30/5/1997 was found suitable/unsuitable.		
		
	Date	Record of Station
<p>Not to Scale</p> <p>This section to be completed by officer constructing pillar.</p> <p>Original station mark found/not found.</p> <p>Description of mark: .....</p> <p>Original beacon found/not found.</p> <p>Description of beacon: .....</p> <p>Height Top of Vane to Top Mark.....m.</p> <p>Height of mark.....m. above G.L. below</p> <p>Diameter of Vane.....m. Height of Cairn.....m.</p> <p>Original Beacon has/has not been destroyed by me.</p>		