

CENTRAL MAPPING AUTHORITY GEODETTIC SURVEY OF N.S.W. STATION: **Cowabie** No.: **1670**

GEODETTIC STATION RECONNAISSANCE and MAINTENANCE REPORT

MAPSHEET SCALE 1:250 000 **MARRANDERA**

INSPECTED BY: **G. KEEP** DATE: **22.7.82** FIELD BOOK:

AUTHORITY: **C. M. A.**

Station Diagram Not to Scale

Description:

1. Cleared by lanes bearing from Trig. Mast

2. ~~Mast & Vanees have been painted white & black respectively.~~

3. The station/pillar was unpiled/not unpiled/constructed on 19 dimensions now being:
 Description of mark should be explicit, e.g. S/Steel Pillar Plate, Steel plug, Brass plug, Bolt, G.I. Pipe
 Height of mark m. ^{above} _{below} rock/concrete; Mark is m. ^{above} _{below} G.L.
 Height of Top Vanes to Top Mark/Pillar plate m. Diameter of Vanes (vertical) m.
 Height of Cairn m. Diameter of Cairn m. Name Plate found/not found/placed.
 Length of Mast m. (approximate if not unpiled) Name imprinted on vanes.

4. A set in conc/rock has been placed/found, bearing M from Mast/Plug/Pillar

5. A set in conc/rock has been placed/found, bearing M from Mast/Plug/Pillar

6. A set in conc/rock has been placed/found, bearing M from Mast/Plug/Pillar

7. A set in conc/rock has been placed/found, bearing M from Mast/Plug/Pillar

8. Action required: Cairn needs replacing, new mast (vanes are in good condition and can be reused), 360° clearing

| STANDPOINT: | | | |
|-------------|-----------|-----------------|-------------------|
| Mark | Direction | Horiz. Distance | Height Difference |
| | | | above standpt |
| | | | below |
| | | | above standpt |
| | | | below |
STANDPOINT: Mark Direction Horiz. Distance Height Difference

Prepared by: **gofy Keep** + 8.82 Checked: Noted on U.T.M. Card

Checked


STATION **Cowabbie TS 1670**

Owner's Name:
 Address:
 Phone:
 Current Occupant:
 Address:
 Phone:

ACCESS
 Access Report of 23/1/1982 was found suitable/unsuitable.
 For access see Bogalong Hills 1:50 000

Trig. Information.
 Trigonometrical Station was found in a run-down condition; cairn needs rebuilding with a new mast required to support vanes. Vanes are in very good condition and can be re-used. 360° clearing needed.

51 2733-2 D. West, Government Printer

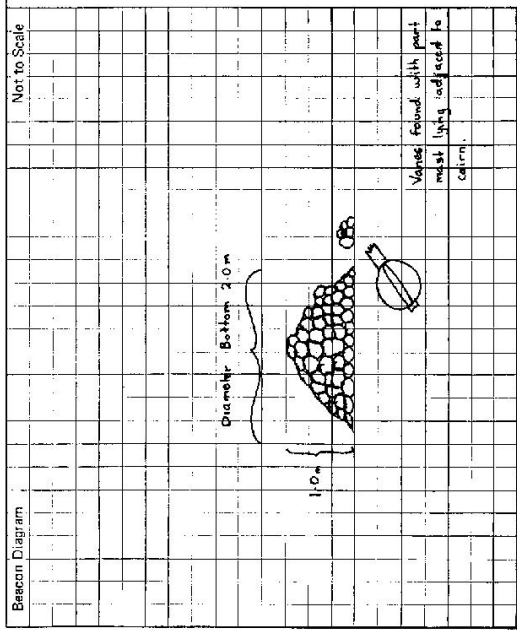

This section to be completed by officer constructing pillar.

Original station mark found/not found.

Description of mark:
 Original beacon found/not found.
 Description of beacon:
 Height Top of Vanes to Top Markm.
 Height of markm. above G.L. below
 Diameter of Vanesm. Height of Cairnm.
 Original Beacon has/has not been destroyed by me.

| Date | Record of Station |
|------|-------------------|
| | |
| | |
| | |
| | |