
	CENTRAL MAPPING AUTHORITY	<b>AUTHORIT</b>											i
			GEC	GEODETIC STATION RECONNAISSANCE and MAINTENANCE REPORT	RECONNAISSAN	CE and MAINTEN.	ANCE REPO	вт	STATION: COWRAJAGO	OWRA	TRGO	No.: 1682	80
	Description:			No	te: Cross out word	Note: Cross out word or words which do not apply	Vidde ton c		MAP SHEET SCALE 1:250 000		CANBERRA		
2	Cleared by lanes be	aring	NOT	Cleared by lanes bearingfor Trig. Mast	~~~~~~~~~~~~~~~~~~~~~~~~~~~~~~~~~~~~~~~	from Tr	ig, Mast		INSPECTED BY:	WM	W MILLER	DATE: 12.6.78	20
~	Mast & Vanes have	been paint	ed white {	Mast & Vanes have been painted white & black respectively.					AUTHORITY:	CMA		FIELD BOOK:	
e,	Th <del>e station/pillar</del> v	vas unpiled/	/not unpil	Th <del>e station/pillar</del> was un <del>pila</del> d/not unpiled/ <del>sonstructsd_o</del> n19	1	9, dimensions	now being:	3. 50	945 95E	10 350	360 10	/ zu/ 30'	
	Description of mark		oussho	Description of markshould be explicit, e.g., \$/Steel Pillar Plate, Steel plug, Brass plug, Bolt, G.I. Pipe	, S/Steel Pillar Plate	e, Steel plug, Brass	plug, Bolt, G	.I. Pipe	Station Diagram	E	North	Not to Scale	
-	Height of markm. <sup>above</sup> rock/concrete;	Ë	<sub>below</sub> rock	/concrete;	Mark ism. above G.L.	.m. <sup>above</sup> G.L.							
	Height of Top Vanes to Top Mark/Pillar	es to Top N	1ark/Pillar	r platem.		Diameter of Vanes (vertical)m.	tical)	Ē	0				
-	Height of Cairnm.		m.	Diameter of Ci	Diameter of Cairnm.	Name Plate found/not found/placed.	nd/not found	/placed.	ιέ /				
-	Length of Mastmm.		É	(approximate if not unpiled)	t unpiled)				QUE				
4	A	i tet i	n conc/ro	A	'found, bearing	°M from Mas	t/Plug/Pillar		0				
5 2	Α	set i	n conc/ro	A	found, bearing		from Mast/Plug/Pillar	<u></u>	3ź /				
6.	Α	set in	n conc/ro	Aset in conc/rock has been placed/found, bearing	found, bearing		from Mast/Plug/Pillar		580				
	Α	set ii	n conc/ro	7. Aset in conc/rock has been placed/found, bearing	'found, bearing		from Mast/Plug/Pillar		042		+		
~	Action required:			8. Action required:					560				
ST	STANDPOINT:				STANDPOINT:				0				
	Mark	Direction	Horiz. Distance	Height Difference	War∖⊲	Direction	Horiz. Distance H	Height Difference	ş \				
				cbove standpt. helow				above standpt.	540				
				ahove standptu below				above Delow standpt					
				ahove standpt. below				above halow standpt.	nez				
				above standpt. below				above standpt.					
				above standpt. helow				above standpt.	C				
				above standpt. below				below standpt.	νζ				
				above standpt. below				ubove standpt. below	210 / 20	200 / 190	0 180 170	160	150
	Depresent hur			Churbart		Me	Mated on U.T.M. Card	Card		Che	Cherked		

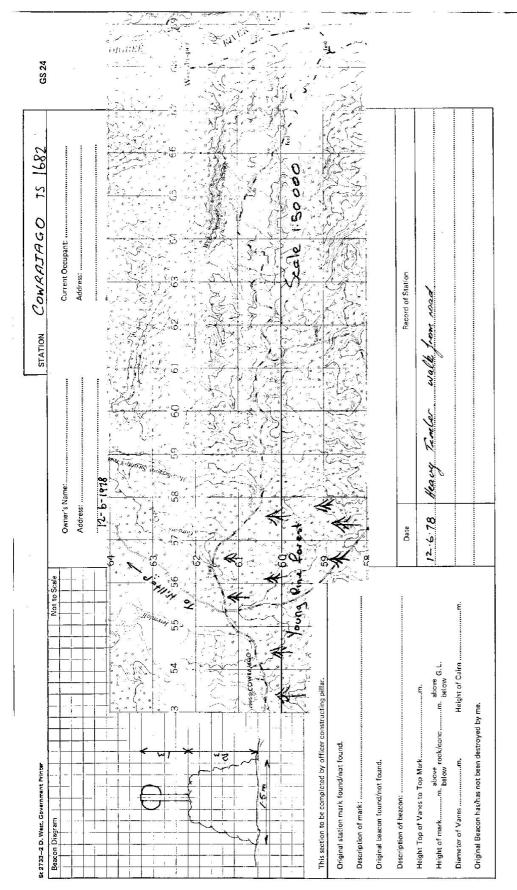

## TS1682 | Print Date: 31/05/2022 15:29 | No Of Pages: 2 | Property of DFSI - Spatial Services