

CENTRAL MAPPING AUTHORITY  
Department of Lands

Trigonometrical Survey of N.S.W.

RECONNAISSANCE and MAINTENANCE REPORT

STATION **CROCKER**

TS. **1695**

This Trig. Station has been:-

Note: Cross out word or words which do not apply

1. Completely cleared to permit 360° vision to surrounding Trigs.

2. Cleared by lanes bearing..... from Trig. Mast

3. Trig. Mast & Vanes have been painted white & black respectively.

4. The Trig. was unpiled/not unpiled, dimensions now being: .....

Description of mark..... should be explicit e.g. Steel plug, Brass plug, Bell, G.I. Pipe

Height of mark..... m above  
below rock/concrete .....

Height of Top Vanes to Top Mark..... m. Diameter of Vanes (vertical)..... m.

Height of Cairn..... m. Diameter of Cairn..... m.

Length of Mast..... m. (approximate if not unpiled)

5. A..... set in conc/rock has been placed..... m. bearing.....°M from Trig. Mast

6. A..... set in conc/soil has been placed..... m. bearing.....°M from Trig. Mast

7. A..... set in conc/soil has been placed..... m. bearing.....°M from Trig. Mast

8. A..... set in conc/rock has been placed..... m. bearing.....°M from Trig. Mast

9. Connection..... to..... m. bearing.....°M

10. Connection..... to..... m. bearing.....°M

11. Connection..... to..... m. bearing.....°M

12. Connection..... to..... m. bearing.....°M

13. Diff. Ht. .... is..... m. above  
below

14. Diff. Ht. .... is..... m. above  
below

15. Diff. Ht. .... is..... m. above  
below

16. Diff. Ht. .... is..... m. above  
below

Prepared by: *[Signature]* 29/4/78 Checked: .....

Noted on U.T.M. Card

Co: **CROCKER** STATION **CROCKER**  
Map Sheet: **AB64C/DH81C** Ph: **BULLFINCH**  
Inspected by: **AB64C/DH81C** No: **8730 (a) III**  
Authority: **Not to Scale** Date: .....

ACCESS ONLY

Date	Record of Station


STATION CROCKER TS 1695

Owners Name..... Current Occupant.....

Address..... Address.....


Access

Station Diagram

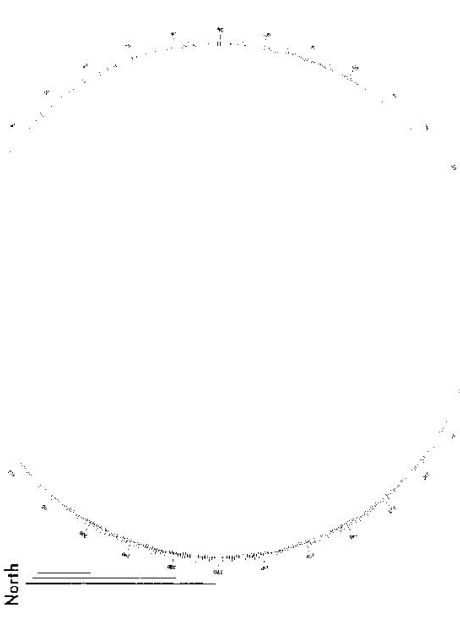

List of Observed Directions:-

Standpoint:		Standpoint:	
Station	Direction	Station	Direction

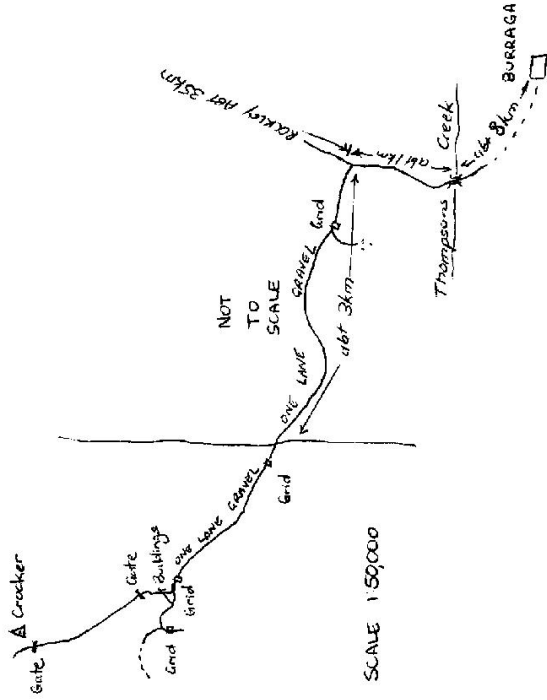

CENTRAL MAPPING AUTHORITY  
Department of Lands

Trigonometrical Survey of N.S.W.

RECONNAISSANCE and MAINTENANCE REPORT

STATION **CROCKER**

TS. **1695**

This Trig. Station has been:-

Note: Cross out word or words which do not apply

Co: **CROCKERIANA** | Ph: **BURRUMBA**  
 Map Sheet: **AB64C/DH81C** | No: **8730 (a) III**  
 Inspected by: \_\_\_\_\_ | Date: \_\_\_\_\_  
 Authority: \_\_\_\_\_ | Field Book: **Not to Scale**

1. Completely cleared to permit 360° vision to surrounding Trigs.
  2. Cleared by lanes bearing..... from Trig. Mast
  3. Trig. Mast & Vanes have been painted white & black respectively.
  4. The Trig. was unpiled/not unpiled, dimensions now being: ~~..... m above  
..... m below~~
- Description of mark..... should be explicit e.g. Steel plug, Brass plug, Bell, G.I. Pipe
- Height of mark..... m above  
..... m below G.L.
- Height of Top Vanes to Top Mark..... m. Diameter of Vanes (vertical)..... m.
- Height of Cairn..... m. Diameter of Cairn..... m.
- Length of Mast..... m. (approximate if not unpiled)
5. A..... set in conc/rock has been placed..... m. bearing.....°M from Trig. Mast
  6. A..... set in conc/soil has been placed..... m. bearing.....°M from Trig. Mast
  7. A..... set in conc/soil has been placed..... m. bearing.....°M from Trig. Mast
  8. A..... set in conc/rock has been placed..... m. bearing.....°M from Trig. Mast
  9. Connection..... to..... m. bearing.....°M
  10. Connection..... to..... m. bearing.....°M
  11. Connection..... to..... m. bearing.....°M
  12. Connection..... to..... m. bearing.....°M
  13. Diff. Ht. .... is..... m. above  
..... m. below
  14. Diff. Ht. .... is..... m. above  
..... m. below
  15. Diff. Ht. .... is..... m. above  
..... m. below
  16. Diff. Ht. .... is..... m. above  
..... m. below

ACCESS ONLY

Date	Record of Station

Noted on U.T.M. Card

Prepared by: *[Signature]* 29/4/78 Checked: \_\_\_\_\_

Checked

STATION CROCKER TS 1695

Current Occupant


Owners Name

Address

Address

Access

Station Diagram Not to Scale

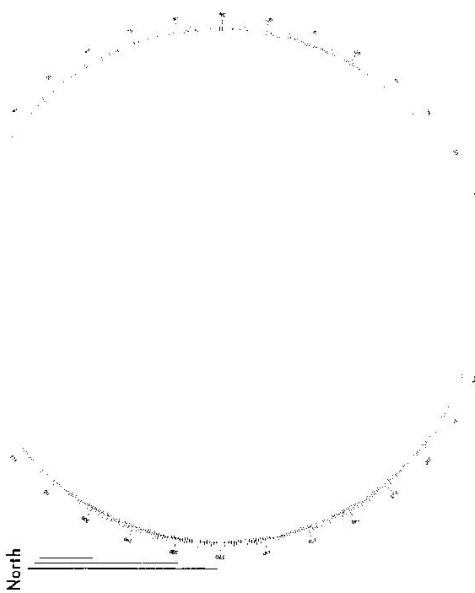

List of Observed Directions:-

Standpoint: Station Direction

Station	Direction	Station	Direction

Standpoint: Station Direction

Station	Direction	Station	Direction

