

CENTRAL MAPPING AUTHORITY

GEODETIC SURVEY OF N.S.W.

GEODETIC STATION RECONNAISSANCE and MAINTENANCE REPORT

Description:

1. Cleared by lanes bearing  $0^{\circ} - 220^{\circ} +$  *Scrubby Trees* *Note: Cross out word or words which do not apply* from Trig. Mast

2. Mast & Vanes have been painted white & black respectively.

3. The station/pillar was unpiled/not unpiled/constructed on ..... 19....., dimensions now being:

Description of mark..... should be explicit, e.g., S/Steel Pillar Plate, Steel plug, Brass plug, Bolt, G.I. Pipe

Height of mark..... m. <sup>above</sup> rock/concrete; Mark is..... m. <sup>above</sup> G.L.

Height of Top Vanes to Top Mark/Pillar plate ..... m. Diameter of Vanes (vertical)..... m.

Height of Cairn..... m. Diameter of Cairn..... m. Name Plate found/not found/placed.

Length of Mast ..... m. (approximate if not unpiled)

4. A..... set in conc/rock has been placed/found, bearing.....  $^{\circ}$  M from Mast/Plug/Pillar

5. A..... set in conc/rock has been placed/found, bearing.....  $^{\circ}$  M from Mast/Plug/Pillar

6. A..... set in conc/rock has been placed/found, bearing.....  $^{\circ}$  M from Mast/Plug/Pillar

7. A..... set in conc/rock has been placed/found, bearing.....  $^{\circ}$  M from Mast/Plug/Pillar

8. Action required: *Ab. Marks Found. Sketch is set. LIME value. Manages. will not allow clearing*


STANDPOINT:

Mark	Direction	Horiz. Distance	Height Difference	Mark	Direction	Horiz. Distance	Height Difference
			above standpt				above standpt
			below				below
			above standpt				above standpt
			below				below
Prepared by: *Phil G... 13/05* Checked:


SI 2733-1

Noted on U.T.M. Card

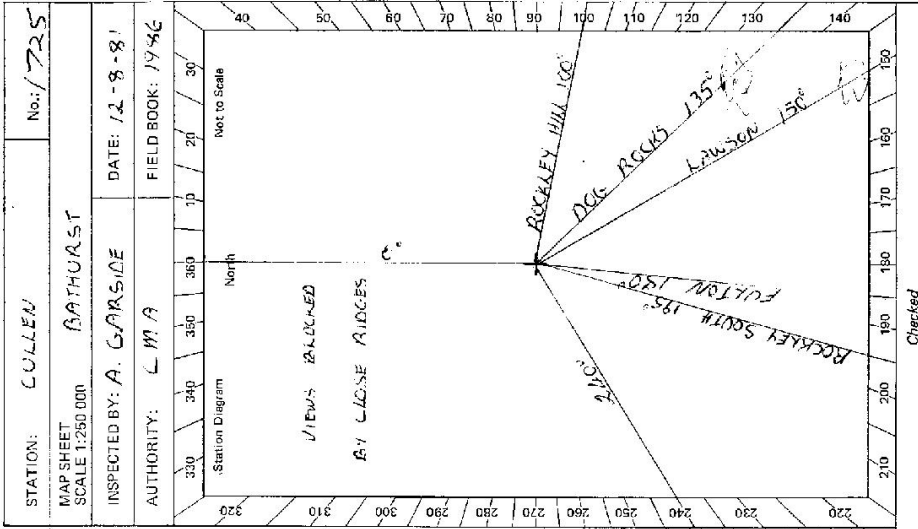

St 2735-2 D. West, Government Printer

STATION **CULLEN TS 1725**

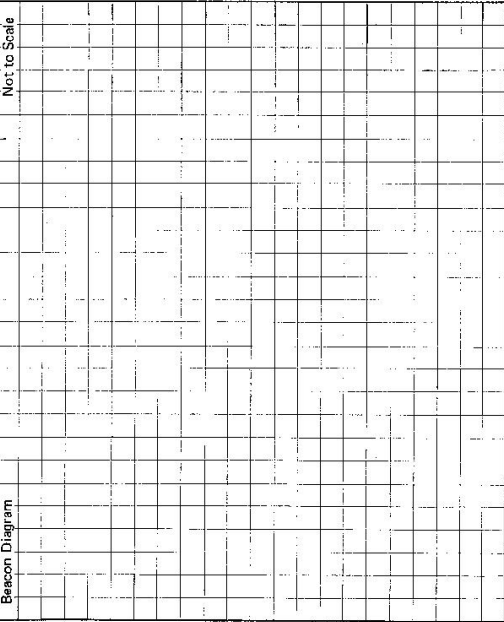

MANAGER'S  
 Owner Name: **PETER EDKINS**  
 Address: **DUNNS PLAINS**  
**MEMORABLE RD ROCKLEY**  
 Phone: **ROCKLEY 87**

Current Occupant:  
 Address:  
 Phone:

**ACCESS**

Access Report of **A 2/198** was found suitable/suitable.

- Km **Feature**
- 0.0 **ROCKLEY RD HEAD UP HILL ST TOWARDS TANNERY**
- 0.2 **TURN RIGHT INTO "PEPPER ST"**
- 1.35 **TURN RIGHT "DEWARINE RD"**
- 3.8 **MANAGER'S HOUSE ON RIGHT. CALL IN**
- 3.85 **CROSS PEPPERS CK.**
- 4.3 **THROUGH DOUBLE IRON GATES ON RIGHT AND FOLLOW TRACKS STRAIGHT AHEAD**
- 5.4 **THROUGH TWO IRON GATES ON LHS OF YARDS TAKE TRACKS DOWN TO RIGHT**
- 5.7 **BOGGY SECTION**
- 5.9 **IRON GATE. CROSS CULLY AND VEER RIGHT TOWARDS ELECTRIC FENCE**
- 6.1 **HEAD UP HILL TO LEFT ALONG ELECTRIC FENCE**
- 6.9 **VEER LEFT AWAY FROM FENCE AT PINES AT TOP OF HILL AND DRIVE ALONG TOP OF RIDGE**
- 7.3 **VEER LEFT JUST BEFORE LARGE TREE AND HEAD UP SLOPE TO TOP OF HILL ON LEFT**
- 7.6 **CULLEN G.S.**

Date	Record of Station

This section to be completed by officer constructing pillar.

Original station mark found/not found.

Description of mark: .....

Original beacon found/not found.

Description of beacon: .....

Height Top of Vanes to Top Mark .....m.

Height of mark .....m. above G.L. below

Diameter of Vanes .....m. Height of Cairn .....m.

Original Beacon has/has not been destroyed by me.