

CENTRAL MAPPING AUTHORITY

GEODETIC SURVEY OF N.S.K.
 GEODETIC STATION RECONNAISSANCE and MAINTENANCE REPORT

Description:
 1. Cleared by lanes bearing.....
 Note: Cross out word or words which do not apply

- 2. Mast & Vanes have been painted white & black respectively.
- 3. The station/pillar was unpiled/not unpiled/constructed on.....19..... dimensions now being:
 Description of mark.....should be explicit, e.g., S/Steel Pillar Plate, Steel plug, Brass plug, Bolt, G.I. Pipe
 Height of mark.....m. ^{above}/_{below} rock/concrete; Mark is.....m. ^{above}/_{below} G.L.
 Height of Top Vanes to Top Mark/Pillar plate.....m. Diameter of Vanes (vertical).....m.
 Height of Cairn.....m. Diameter of Cairn.....m. Name Plate found/not found/placed.
 Length of Mast.....m. (approximate if not unpiled)
- 4. A.....set in conc/rock has been placed/found, bearing.....°M from Mast/Plug/Fillar
- 5. A.....set in conc/rock has been placed/found, bearing.....°M from Mast/Plug/Pillar
- 6. A.....set in conc/rock has been placed/found, bearing.....°M from Mast/Plug/Pillar
- 7. A.....set in conc/rock has been placed/found, bearing.....°M from Mast/Plug/Pillar
- 8. Action required:.....

STANDPOINT:

| Mark | Direction | Horiz. Distance | Height Difference | Mark | Direction | Horiz. Distance | Height Difference |
|------|-----------|-----------------|--|------|-----------|-----------------|--|
| | | | ^{above} / _{below} standpt. | | | | ^{above} / _{below} standpt. |
| | | | ^{above} / _{below} standpt. | | | | ^{above} / _{below} standpt. |
Prepared by: *[Signature]*

24/1/19

Checked

st2733-1

STATION: **COMBERTINE G.S.** No.: **1732**
 MAP SHEET: **WOLLONGONG**
 SCALE: 1:250 000
 INSPECTED BY: **M.L. Morrison** DATE: **15-1-79**
 AUTHORITY: **C.M.A.** FIELD BOOK: **1720**

Station Diagram

Not to Scale

Trig found in good condition.
 G.I. Pipe in conc in next lot.
 SSM in conc a lot.

Hill cleared by lanes bearing 22 to 33°
 50 to 52° of 152m to 270m (close
 ridge blocking vision in this direction
 to the South but clearer tower shall
 can be seen through a saddle)
 Any more clearing would be very
 extensive and its height at
 least per bench

81 2732-2 D. West, Government Printer


STATION **CUMBERTINE G.S. IS 1732**

Owner's Name:
 Address:
 Phone:

Current Occupant:
 Address:
 Phone:

ACCESS
 Access Report of...../19..... was found suitable/unsuitable.
 Km **Direction.**

0.00 **Hilltop Rd. Head west along LINCOLN ST.**
 0.40 **Turn left at 'T' Junction**
 0.70 **Turn right into SACRAMENT ST.**
 1.28 **Pass Village Rd on right**
 1.30 **Turn right onto track next to fence line**
 2.00 **Pass West Rd fire trail on right follow Trig Rd fire trail**
 3.50 **Trig just on left.**

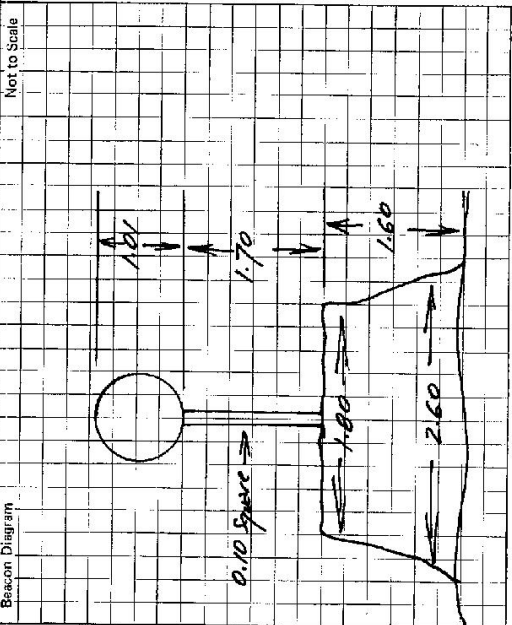

This section to be completed by officer constructing pillar.

Original station mark found/not found.

Description of mark:

Original beacon found/not found.

Description of beacon:

Height Top of Vane to Top Markm.
 above G.L. below

Height of markm.
 above G.L. below

Diameter of Vanem. Height of Cairnm.

Original Beacon has/has not been destroyed by me.

| Date | Record of Station |
|------|-------------------|
| | |
| | |
| | |