

CENTRAL MAPPING AUTHORITY


GEODETIC STATION RECONNAISSANCE and MAINTENANCE REPORT

- STATION: CUMBALITOWA C.S. No: 15-1734
 MAP SHEET SCALE 1:250 000 FORSES
 INSPECTED BY: R. LANDER DATE: 15-1-80
 AUTHORITY: C.M.A. FIELD BOOK: 1786
- Description: *Note: Cross out word or words which do not apply*
- Cleared by Janes bearing $287^{\circ} 32' 00''$ \rightarrow $327^{\circ} 00' 00''$ \rightarrow $145^{\circ} 00' 00''$ \rightarrow $177^{\circ} 00' 00''$ \rightarrow $183^{\circ} 00' 00''$ from Trig. Mast
 - Mast & Vanes have been painted white & black respectively.
 - The station ~~was~~ was unpiled/~~not unpiled~~/~~constructed~~ on $16-1$ \rightarrow 18.80 m, dimensions now being: Description of mark: ~~Brass Plug~~ Plug should be explicit, e.g., S/Steel Pillar Plate, Steel plug, Brass plug, Bolt, G.I. Pipe
 Height of mark 3.71 m. ^{above} ~~below~~ rock/concrete; Mark is 3.71 m. ^{above} ~~below~~ G.L.
 Height of Top Vanes to Top Mark/~~Pillar plate~~ 3.71 m. Diameter of Vanes (vertical) 0.130 m.
 Height of Cairn 1.10 m. Diameter of Cairn 2.2 m. Name Plate found/not found/placed.
 Length of Mast 3.71 m. (approximate if not unpiled)
 - A 1.0 set in conc/rock has been placed/found, bearing $0^{\circ} 00' 00''$ M from Mast/Plug/Pillar
 - A 1.0 set in conc/rock has been placed/found, bearing $353^{\circ} 09' 30.5''$ M from Mast/Plug/Pillar
 - A 1.0 set in conc/rock has been placed/found, bearing $205^{\circ} 21' 12''$ M from Mast/Plug/Pillar
 - A 1.0 set in conc/rock has been placed/found, bearing $0^{\circ} 00' 00''$ M from Mast/Plug/Pillar
 - Action required: ~~Radars clearing with chainsaws~~

STANDPOINT: ~~Trig. Plug~~ **Trig. Plug** STANDPOINT: **C.I. PIPE** A

Mark	Direction	Horiz. Distance	Height Difference	Mark	Direction	Horiz. Distance	Height Difference
ALCHEMICA T.P.	$0^{\circ} 00' 00''$		above standpt	MUMBIDOLE G.S.P.	$0^{\circ} 00' 00''$		above standpt
MUMBIDOLE G.S.P.	$6^{\circ} 50' 14''$		above standpt	ALCHEMICA T.P.	$353^{\circ} 09' 30.5''$		above standpt
G.I. Pipe	$32^{\circ} 12' 33''$	14.660	above standpt	TRIG. PLUG	$205^{\circ} 21' 12''$	14.658	above standpt
			below standpt				below standpt
			above standpt				above standpt
			below standpt				below standpt
			above standpt				above standpt
			below standpt				below standpt

Prepared by: **D. HALLS** Checked: *Noted on U.T.M. Card*

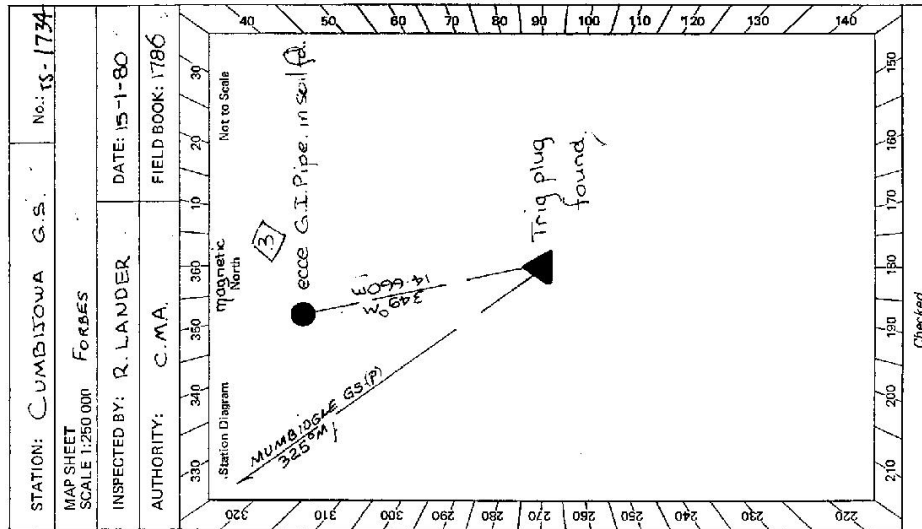

CENTRAL MAPPING AUTHORITY

GEODETIC SURVEY OF N.S.W.

GEODETIC STATION RECONNAISSANCE and MAINTENANCE REPORT

STATION: CLIMBILOWA No.: 1734

MAP SHEETS SCALE 1:250 000


INSPECTED BY: J Judge

DATE: 23.5.89

AUTHORITY: C.M.A.

FIELD BOOK:

- Description:
- Cleared by James-bearing. *Consistently. 40 M. from Trig. Mast then 141 M - 283 M*
 - Mast & Vanes have been painted white & black respectively.
 - The station/pillar was emptied/not unpiled/constructed on *19*....., dimensions now being: Description of mark..... should be explicit, e.g., S/Steel Pillar Plate, Steel plug, Brass plug, Bolt, G.I. Pipe Height of mark..... m. above below rock/concrete; Mark is..... m. above below G.L. Height of Top Vanes to Top Mark/Pillar plate..... m. Diameter of Vanes (vertical)..... m. Height of Cairn..... m. Diameter of Cairn..... m. Name Plate found/not found/placed. Length of Mast..... m. (approximate if not unpiled)
 - A..... set in conc/rock has been placed/found, bearing.....°M from Mast/Plug/Pillar
 - A..... set in conc/rock has been placed/found, bearing.....°M from Mast/Plug/Pillar
 - A..... set in conc/rock has been placed/found, bearing.....°M from Mast/Plug/Pillar
 - A..... set in conc/rock has been placed/found, bearing.....°M from Mast/Plug/Pillar
 - Action required:.....

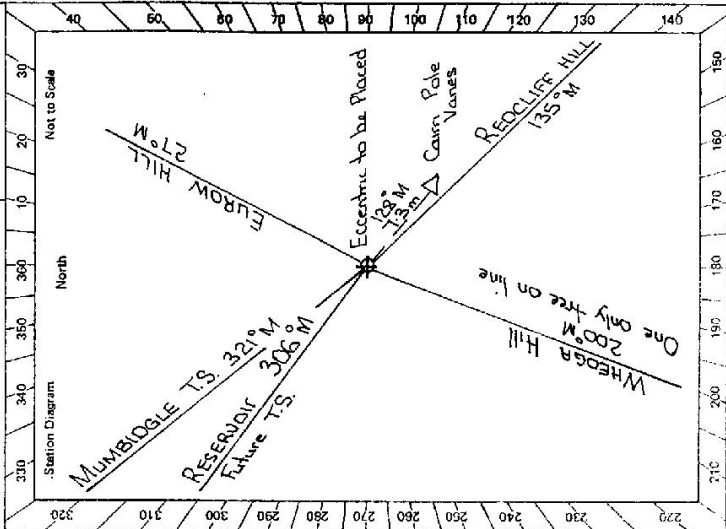

STANDPOINT:							
Mark	Direction	Horiz. Distance	Height Difference	Mark	Direction	Horiz. Distance	Height Difference
			above standpt				above standpt
			below standpt				below standpt
			above standpt				above standpt
			below standpt				below standpt
Prepared by: *R. J. Wigg 16/6/89* Checked: *Named on U.T.M. Grid*

GS 24

STATION CUMBLIOWA ^{TS} GS 1734	Owner's Name: JEFFREY STYLES Address: "MARAWONG" Phone: ELLIS LANE Phone: 068 534126 Current Occupant: Address: Phone: ACCESS 12-9-1987 Access Report of 1.12.1977 was found suitable/unsuitable. ACCESS VIA ELLIS LANE ABOUT 12-14 AM OUT OF PARKER ON LAMHAY VALLEY WAY TOWARDS CONRA THRU TO END OF ELLIS LANE TO OWNERS HOUSE C.S. ON HILL BEHIND HOUSE
Beacon Diagram Not to Scale 	This section to be completed by officer constructing pillar. Original station mark found/not found. Description of mark: Original beacon found/not found. Description of beacon: Height Top of Vanes to Top Mark:m. Height of mark:m. above G.L. below Diameter of Vanes:m. Height of Cairn:m. Original Beacon has/has not been destroyed by me.
	Date Record of Station ELLIS LANE TO P. CONRA. PILLAR COULD BE PLACED