



2793-2 D. West, Government Printer Beacon Diagram:	STATION <b>CUNNINGDROO TS 1740</b>	Owner's Name: <u>not known</u> Address: ..... Phone: ..... Current Occupant: ..... Address: ..... Phone: .....	ACCESS Access Report of <u>28.5.92</u> was found suitable/unsuitable.	From Wagga take the Stuart Highway towards Sydney to Widgiewa Stud, Borumbola, turn left on Wokolena Rd 0.0 kms Wokolena Rd Inter 3.6 kms Entrance gate Wokolena Str on right Through gate, cross 2 cattle grids to wooden bridge 5.1 kms Wooden bridge - straight ahead to owner's house bridge. Uphill run along track to Trig over cyclone gates. 6.16 kms Double gates, take L.H., follow track along ridge line to TS on open hill	Date <u>7.12 km Trig Station</u> Record of Station
Not to Scale 		This section to be completed by officer constructing pillar. Original station mark found/not found. Description of mark: ..... Original beacon found/not found. Description of beacon: ..... Height Top of Vanes to Top Mark: .....m. Height of mark: .....m. above S.L. below Diameter of Vanes .....m. Height of Cairn: .....m. Original Beacon has/has not been destroyed by me.			
28.5.92		leaning timber mast in rock cairn			

LAND INFORMATION CENTRE

GEODETIC SURVEY OF N.S.W.

GEODETIC STATION RECONNAISSANCE and MAINTENANCE REPORT

Description:

1. Cleared by vanes bearing **Good for GPS** (Scattered Elev 20' to East) from Trig. Mast  
*Note: Cross out word or words which do not apply*
2. Mast & Vanes have been painted white & black respectively. **NO**
3. The station/pillar was unpiled/~~not pilled~~/~~connected~~ on **11 MAR. 2004**, dimensions now being: **Brass Trig**  
Description of mark..... should be explicit, e.g., S/Steel Pillar Plate, Steel plug, Brass plug, Bolt, G.I. Pipe  
Height of mark **0.025** m. above rock/~~concrete~~; Mark is **0.1** m. ~~above~~ below G.I.  
Height of Top Vanes to Top Mark/~~pillar plate~~ **2.95** m. Diameter of Vanes (vertical) **0.76** m.  
Height of Cairn **1.0** m. Diameter of Cairn **2.5** m. Name ~~is~~ **on Vanes** ~~found~~ ~~not found~~ ~~placed~~.  
Length of Mast **3.2** m. (approximate if not unpiled)  
4. **PM 72430** set in ~~concrete~~ **soil & Cover Box** has been placed/found, bearing **153** °M from Mast/Plug/Pillar  
5. **A** set in conc/rock has been placed/found, bearing..... °M from Mast/Plug/Pillar  
6. **A** set in conc/rock has been placed/found, bearing..... °M from Mast/Plug/Pillar  
7. **A** set in conc/rock has been placed/found, bearing..... °M from Mast/Plug/Pillar  
8. Action required:.....

STANDPOINT: Trig Plug in rock

STANDPOINT: PM 72430

Mark	Direction	Horiz. Distance	Height Difference	Mark	Direction	Horiz. Distance	Height Difference
Wheel of Fortune (P)	0 00 00		above standpt	Wheel of Fortune (P)	0 00		above standpt
PM 72430	197 53 17	4.021	above standpt	Trig Plug	17 52 55	4.021	below standpt
Mirror flash from (P)			below				above standpt
			above standpt				below
			below				above standpt
			above standpt				below
			below				above standpt
			above standpt				below
			below				above standpt

Prepared by: **A. Sivertsen**

Checked: **C. Hebb** 30/3/04

Noted on U.T.M. Card

S: 2733-1

STATION: **CUNNINGDROO** No.: **1740**

MAP SHEET SCALE 1:250 000 **WAGGA**

INSPECTED BY: **A. Sivertsen** DATE: **11 MAR 04**

AUTHORITY: **LANDS** FIELD BOOK: **2108**

Station Diagram

North

330 340 350 360 370 380 390 400 410 420

320 310 300 290 280 270 260 250 240 230

Not to Scale

30 20 10 0 10 20 30

TS1740

Wheel of Fortune (P)

315° M

Trig Plug in rock

152° M

102° M

17430

Cover Box

Station Book

1103


TX 47490

PM = 226020

TS1740 (+0.098)

Checked

TS 2733-2 D. West, Government Printer

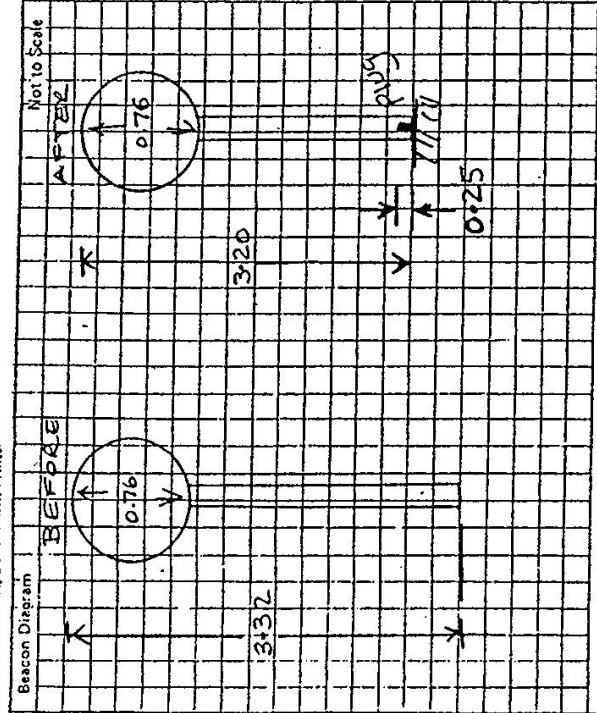

STATION CUNNINGDROO

Owner's Name: Bruce Harris  
 Address: "WOKOLENA"  
 Mokolena Road WAGGA  
 Phone: 0427 040 375

Current Occupant:  
 Address:  
 Phone:

ACCESS

Access Report of ...../19..... was found suitable/unsuitable. 2WD in dry  
 About 14km East of WAGGA on Sturt Hwy at ALFREDTOWN.  
 0.0 L HWY and road to TUMBRUNGA. Head East on HWY.  
 1.9 Turn L onto WOKOLENA ROAD.  
 4.9 Turn L through double iron gates "WOKOLENA"  
 6.1 & 6.3 Grids  
 6.4 After bridge take R fork up spur.  
 7.5 At 2 sets of gates. Take single gate to L  
 of double gates. Follow track.  
 8.4 CUNNINGDROO TS

This section to be completed by officer constructing pillar.

Original station mark found/not found.  
 Description of mark: .....  
 Original beacon found/not found.  
 Description of beacon: .....  
 Height Top of Vanes to Top Mark: .....m.  
 Height of mark: .....m. above G.L. below  
 Diameter of Vanes .....m. Height of Cairn .....m.  
 Original Beacon has/has not been destroyed by me.

Date	Record of Station

TS1740