

CENTRAL MAPPING AUTHORITY

GEODETIC SURVEY OF M.S.W.

GEODETIC STATION RECONNAISSANCE and MAINTENANCE REPORT


STATION: **CURRIBA** No: **1755**

MAP SHEET SCALE 1:250 000 **CARGELLIGO**

INSPECTED BY: **G.C. HANNA** DATE: **23/5/19**

AUTHORITY: **C.M.A.** FIELD BOOK:

- Description:
1. Cleared by lanes bearing..... *Note: Cross out word or words which do not apply*..... from Trig. Mast
 2. Mast & Vanes have been painted white & black respectively.
 3. The station/pillar was unpiled/not unpiled/constructed on..... 19....., dimensions now being:
Description of mark..... should be explicit, e.g., S/Steel Pillar Plate, Steel plug, Brass plug, Bolt, G.I. Pipe
Height of mark..... m. ^{above} rock/concrete; Mark is..... m. ^{above} G.L.
 4. A..... set in conc/rock has been placed/found, bearing..... ° M from Mast/Plug/Pillar
 5. A..... set in conc/rock has been placed/found, bearing..... ° M from Mast/Plug/Pillar
 6. A..... set in conc/rock has been placed/found, bearing..... ° M from Mast/Plug/Pillar
 7. A..... set in conc/rock has been placed/found, bearing..... ° M from Mast/Plug/Pillar
 8. Action required:.....
- Height of Top Vanes to Top Mark/Pillar plate..... m. Diameter of Vanes (vertical)..... m.
 Height of Cairn..... m. Diameter of Cairn..... m. Name Plate found/not found/placed.
 Length of Mast..... m. (approximate if not unpiled)

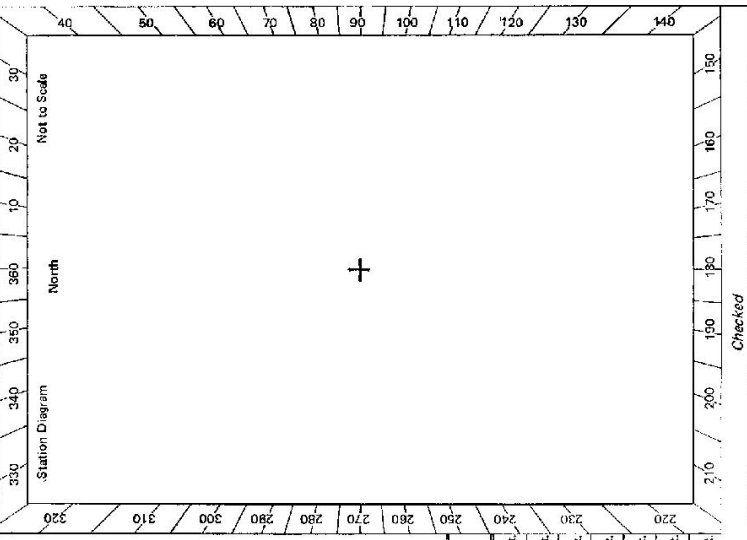

STANDPOINT:

Mark	Direction	Horiz. Distance	Height Difference	Mark	Direction	Horiz. Distance	Height Difference
			above standpt.				above standpt.
			below standpt.				below standpt.
			above standpt.				above standpt.
			below standpt.				below standpt.
Prepared by: *G. Hanna* 23/5/19 Checked: *[Signature]* Noted on U.T.M. Card

SI 2735-2 D. Weir, Government Printer

CURRIBA TS 1755

STATION

Beacon Diagram

Not to Scale

Owner's Name:
 Address:
 Phone:

Current Occupant:
 Address:
 Phone:

ACCESS

Access Report of 23.5/19.1 was found suitable/unsuitable.

Cairn clearly seen from road to NE.

Possible drive to

No clearing required.

Previously visited in 1971.

See also Tullibigeal B231-S

This section to be completed by officer constructing pillar.

Original station mark found/not found.

Description of mark:

Original beacon found/not found.

Description of beacon:

Height Top of Vanes to Top Markm.

Height of markm. above G.L.
 below rock/contcm. below

Diameter of Vanesm.

Height of Cairnm.

Original Beacon has/has not been destroyed by me.

Date	Record of Station