


STATION TS 1780 D ARCY

Owners Name.....
 Current Occupant.....
 Address.....

Address.....


13-12-1978
 Access UBD 35 HQ

Station Diagram Not to Scale

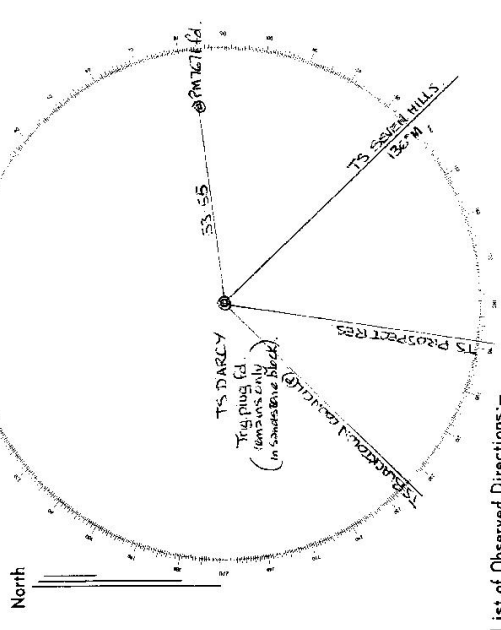

List of Observed Directions:-

Standpoint: Trig plug		Standpoint:	
Station	Direction	Station	Direction
PM17671	82° 35' 18"		
TS SEMEN HILLS	136° 00' 00"		
TS PROSPECT RES	188° 37' 01"		
TS BLANKETEAH (24-NEULP)	224° 01' 02"		
Station	Direction	Station	Direction

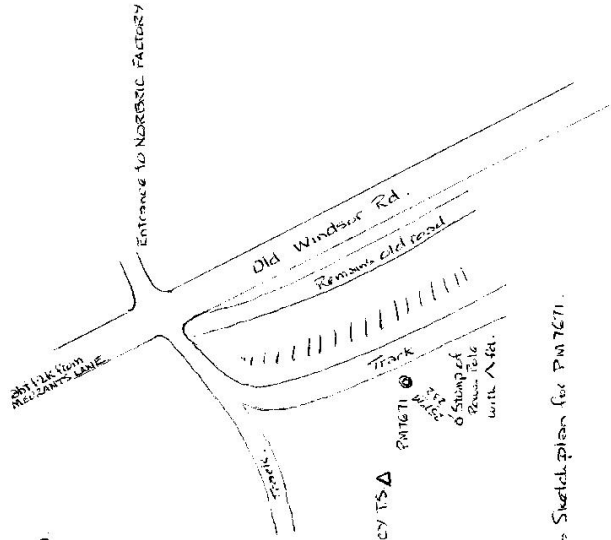

D. West, Government Printer, New South Wales - 1976