

CENTRAL MAPPING AUTHORITY

GEODETIC SURVEY OF M.S.I.W

GEODETIC STATION RECONNAISSANCE and MAINTENANCE REPORT

STATION: DARETON No.: 1781

Description: *Note: Cross out word or words which do not apply*

MAP SHEET SCALE 1:250 000 MILDURA S1/54-11

1. Cleared by lanes bearing..... from Trig. Mast

2. Mast & Vanes have been painted white & black respectively.

3. The station/pillar was unpiled/not unpiled/constructed on..... dimensions now being:

Description of mark..... should be explicit, e.g. S/Steel Pillar/Plate, Steel plug, Brass plug, Bolt, G.I. Pipe

Height of mark.....^{above} rock/concrete; Mark is.....^{above}.....^{below} G.L.

Height of Top Vanes to Top Mark/Pillar plate.....m. Diameter of Vanes (vertical).....m.

Height of Cairn.....m. Diameter of Cairn.....m. Name Plate found/not found/placed.

Length of Mast.....m. (approximate if not unpiled)


4. A.....set in conc/rocky has been placed/found, bearing.....°M from Mast/Plug/Pillar

5. A.....set in conc/rocky has been placed/found, bearing.....°M from Mast/Plug/Pillar

6. A.....set in conc/rocky has been placed/found, bearing.....°M from Mast/Plug/Pillar

7. A.....set in conc/rocky has been placed/found, bearing.....°M from Mast/Plug/Pillar

8. Action required:.....

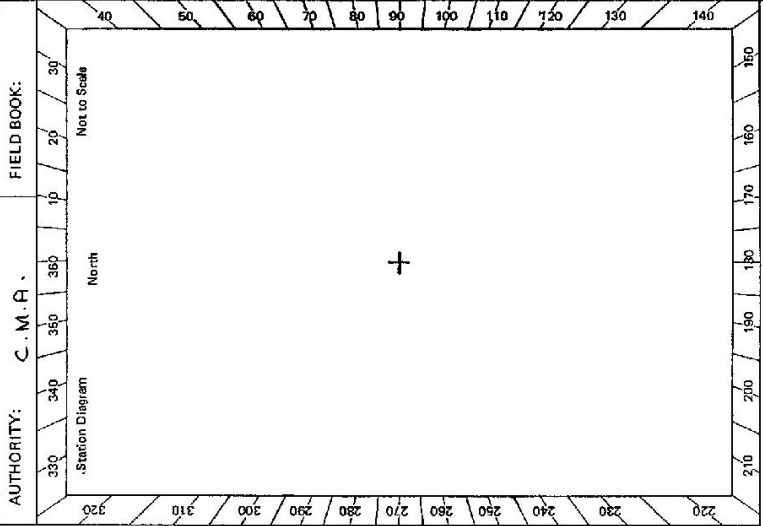

STANDPOINT:				STANDPOINT:			
Mark	Direction	Horiz. Distance	Height Difference	Mark	Direction	Horiz. Distance	Height Difference
			above standpt.				above standpt.
			below standpt.				below standpt.
			above standpt.				above standpt.
			below standpt.				below standpt.

Prepared by: *[Signature]*

Noted on U.T.M. Card

Checked

2733-2-D - West Government Printer

STATION **DARETON** **TS 1781**

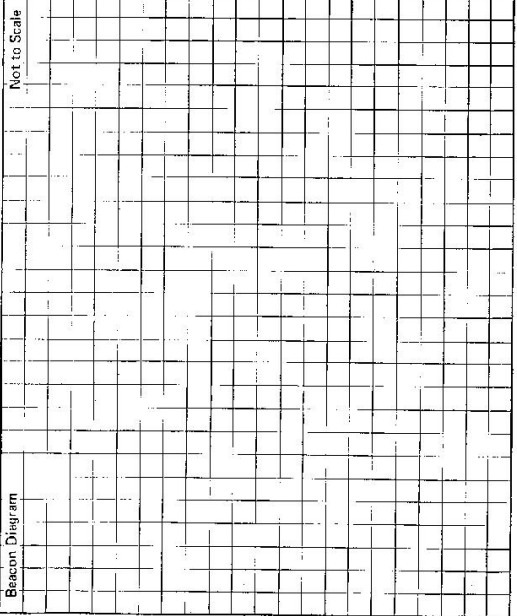

Owner's Name:
 Address:
 Phone:

Current Occupant:
 Address:
 Phone:

ACCESS
 Access Report of 15/3/1983 was found suitable/unsuitable.

Cairn mast & vanes found in reasonable condition.
 Trig almost completely surrounded by orchard.

Access
 0.0 From Dareton P.O head west towards Wentworth.
 2.4 (Approx) Trig situated on RH side of road in orchard.

This section to be completed by officer constructing pillar.

Original station mark found/not found.
 Description of mark:
 Original beacon found/not found.
 Description of beacon:
 Height Top of Vanes to Top Mark:m.
 Height of mark:m. above rock/conem. below G.L.
 Diameter of Vanes:m. Height of Cairnm.
 Original Beacon has/has not been destroyed by me.

Date	Record of Station

LAND INFORMATION CENTRE

GEODETS SURVEY OF A.S.W.

GEODETTIC STATION RECONNAISSANCE and MAINTENANCE REPORT

STATION: **DARETON** No: **1781**

MAP SHEET
SCALE: 1:250 000

DATE: **28.8.91**

FIELD BOOK: **630**

INSPECTED BY: **L. HITCHINS**

AUTHORITY: **L.I.C.**

Description: *Note: Cross out word or words which do not apply*

1. Cleared by James bearing..... from Trig. Mast

2. Mast & Vanes have been painted white & black respectively. **Guanoops over Brass Plug**

3. The station pillar was unpainted unless constructed on....., dimensions now being:

Description of mark..... should be explicit, e.g., S/Steel Pillar Plate, Steel plug, Brass plug, Bol., G.I. Pipe

Height of mark.....m. above rock/concrete; Mark is.....m. above G.L.

Height of Top Vanes to Top Mark/Pillar plate.....m. Diameter of Vanes (vertical).....m.

Height of Cairn.....m. Diameter of Cairn.....m. Name Plate found/not found/placed.

Length of Mast.....m. (approximate if not implied)

4. **A Bolt in Foot of Mast when base of rock has been placed found, bearing 296.5M from Mast/Plug/Pillar**

5. **A Bolt in Foot of Mast when base of rock has been placed found, bearing 217.1M from Mast/Plug/Pillar**

6. **Copper tube in conc. set in conc. rock has been placed found, bearing 13.5M from Mast/Plug/Pillar**

7. A..... set in conc. rock has been placed found, bearing.....M from Mast/Plug/Pillar

8. Action required:.....

STANDPOINT: **BRASS PLUG** STATION POINT: **SSM 72911**

Mark	Direction	Distance	Height Difference		Height Difference	Height Distance
			above standpt	below standpt		
VELTA	0 00 00					
SSM 72911	0 00 00	34.612	2.665		37.277	
DRILLED BOLT	56 38 50	6.115	10.291		16.406	
DRILLED BOLT	106 13 25	3.079	0.112		3.191	
COPPER TUBE	182 44 30	6.424	10.034		16.458	

Prepared by: *L. Hitchins* Checked by: *G. M. Carr* Station: *Dareton* Date: *10.10.91*

