

GEODETTIC SURVEY OF N.S.W

CENTRAL MAPPING AUTHORITY

GEODETTIC STATION RECONNAISSANCE and MAINTENANCE REPORT

Description:

Note: Cross out word or words which do not apply

1. Cleared by lanes bearing.....**360°**..... from Trig. Mast
2. Mast & Vanes have been painted white & black respectively.
3. The station/~~pillar~~ was ~~unpiled~~/~~connected~~ on.....**16.1.1979**....., dimensions now being:
Description of mark.....should be explicit, e.g., S/Steel Pillar Plate, Steel plug, Brass plug, Bolt, G.I. Pipe
Height of mark.....m. ^{above} ~~below~~ rock/concrete; Mark ism. ^{above} ~~below~~ G.L.
Height of Top Vanes to Top Mark/Pillar platem. Diameter of Vanes (vertical).....m.
Height of Cairn.....**1.2**m.....m. Diameter of Cairn.....**2.5**m.....m. Name Plate found/not found/placed.
Length of Mast.....**3.2**m. (approximate if not unpiled)
4. A.....set in conc/rock has been placed/found, bearing.....°M from Mast/Plug/Pillar
5. A.....set in conc/rock has been placed/found, bearing.....°M from Mast/Plug/Pillar
6. A.....set in conc/rock has been placed/found, bearing.....°M from Mast/Plug/Pillar
7. A.....set in conc/rock has been placed/found, bearing.....°M from Mast/Plug/Pillar
8. Action required:.....

STANDPOINT:

Mark	Direction	Horiz. Distance	Height Difference	Mark	Direction	Horiz. Distance	Height Difference
			above standpt.				above standpt.
			below standpt.				below standpt.
			above standpt.				above standpt.
			below standpt.				below standpt.
			above standpt.				above standpt.
			below standpt.				below standpt.
			above standpt.				above standpt.
			below standpt.				below standpt.

Prepared by: *W Miller* **26-1-79**

Checked:

Noted on U.T.M. Carr

Checked

STATION: **DAVELIN** TS No.: **1787**

N.P. SHEET SCALE 1:250 000 **CANBERRA**

INSPECTED BY: **W MILLER** DATE: **16-1-79**

AUTHORITY: **CMA** FIELD BOOK:

Station Diagram

North

Not to Scale

St. 2728-2 D. West, Government Printer


STATION **DAVELIN GS TS 1787**

Owner's Name:
 Address:
 Phone:


Current Occupant:
 Address:
 Phone:

ACCESS
 Access Report of 16.1.79 was found suitable/unsuitable.

Approx 1km north of bridge
 over Michelago Creek leave
 vehicle on road and walk
 15min walk.

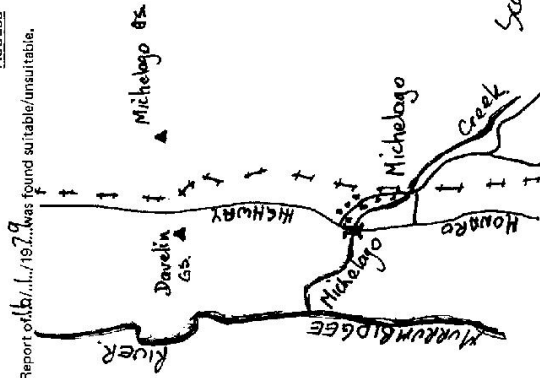

Scale Approx 1:100,000

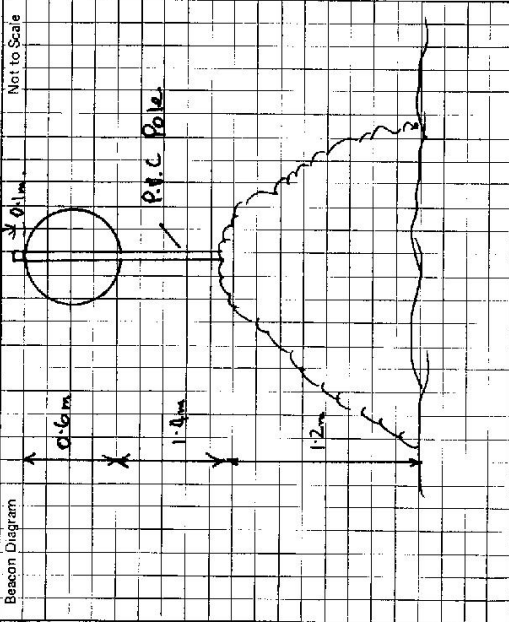

This section to be completed by officer constructing pillar.

Original station mark found/not found.

Description of mark:

Original beacon found/not found.

Description of beacon:

Height Top of Vanes to Top Markm.

Height of markm. above G.L. below rock/cone

Diameter of Vanesm.

Height of Cairnm.

Original Beacon has/has not been destroyed by me.

Date

16.1.79

Record of Station

Visited *X*