

GEODETTIC SURVEY OF N.S.W.

CENTRAL MAPPING AUTHORITY


GEODETTIC STATION RECONNAISSANCE and MAINTENANCE REPORT

STATION: *De Track* No.: *1794*

MAP SHEET SCALE 1:250 000  
 INSPECTED BY: *R. K. Bamola* DATE: *June 19*

AUTHORITY: *CMA* FIELD BOOK:

- Description:  
 Note: Cross out word or words which do not apply
1. Cleared by ~~lance bearing~~ *0° to 180° (approx.)* ..... from Trig, Mast
  2. Mast & Vanes have been painted white & black respectively. ~~need to be replaced~~
  3. The station/pillar was unpiled/not unpiled/~~reconstructed on~~ ..... *40* ..... ~~dimensions now being~~  
*Cairn of rocks found* ..... should be explicit, e.g. S/Steel Pillar Plate, Steel plug, Brass plug, Bolt, G.I. Pipe
- Height of mark.....m. <sup>above</sup> rock/concrete; Mark is.....m. <sup>above</sup> G.L.  
 Height of Top Vanes to Top Mark/Pillar plate .....m. Diameter of Vanes (vertical).....m.  
 Height of Cairn.....m. Diameter of Cairn.....m. Name Plate found/not found/placed.  
 Length of Mast.....m. (approximate if not unpiled)
4. A.....set in conc/rock has been placed/found, bearing.....°M from Mast/Plug/Pillar
  5. A.....set in conc/rock has been placed/found, bearing.....°M from Mast/Plug/Pillar
  6. A.....set in conc/rock has been placed/found, bearing.....°M from Mast/Plug/Pillar
  7. A.....set in conc/rock has been placed/found, bearing.....°M from Mast/Plug/Pillar
8. Action required: *Cleaning to the west of the station. Necessary.*

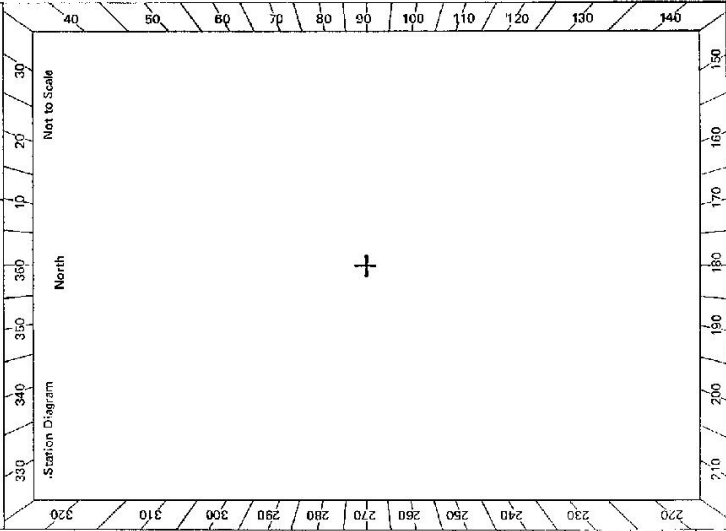

STANDPOINT:

Mark	Direction	Horiz. Distance	Height Difference	Mark	Direction	Horiz. Distance	Height Difference
			above standpt.				above standpt.
			below				below
			above standpt.				above standpt.
			below				below
Prepared by: *R.K. Bamola 14/6/20* Checked: *[Signature]*

Noted on U.T.M. Chart

Sr 2735-1

