

CENTRAL MAPPING AUTHORITY

GEODETIC SURVEY OF NSW
 GEODETIC STATION RECONNAISSANCE and MAINTENANCE REPORT

Description:

1. Cleared by lances bearing Scattered Trees *Note: Cross out word or words which do not apply* from Trig, Mast
 2. Mast & Vanes have been painted white & black respectively.
 3. The station/~~pillar~~ was ~~unpiled/not unpiled/conserved~~ on 1.5 x 1.19.79, dimensions now being: Description of mark.....should be explicit, e.g., S/Steel Pillar Plate, Steel plug, Brass plug, Bolt, G.I. Pipe
- Height of mark.....m. ^{above} rock/concrete; Mark is.....m. ^{above} _{below} G.L.
- Height of Top Vanes to Top Mark/Pillar plate.....m. Diameter of Vanes (vertical).....m.
- Height of Cairn.....m. Diameter of Cairn.....m. Name Plate found/not found/placed.
- Length of Mast.....m. (approximate if not unpiled)
4. A.....set in conc/rock has been placed/found, bearing.....°M from Mast/Plug/Pillar
 5. A.....set in conc/rock has been placed/found, bearing.....°M from Mast/Plug/Pillar
 6. A.....set in conc/rock has been placed/found, bearing.....°M from Mast/Plug/Pillar
 7. A.....set in conc/rock has been placed/found, bearing.....°M from Mast/Plug/Pillar
 8. Action required:.....

STANDPOINT:

Mark	Direction	Horiz. Distance	Height Difference	Mark	Direction	Horiz. Distance	Height Difference
			above standpt.				above standpt.
			below standpt.				below standpt.
			above standpt.				above standpt.
			below standpt.				below standpt.
			above standpt.				above standpt.
			below standpt.				below standpt.
			above standpt.				above standpt.
			below standpt.				below standpt.

Prepared by: W. Miller 26-1-79 Checked: W. Miller 26-1-79 *Noted on U.T.M. Card*

St 2733-1

STATION: **DE SALIS GS** No.: **1814**
 MAP SHEET SCALE 1:250 000 **CANBERRA**
 INSPECTED BY: **W MILLER** DATE: **15-1-79**
 AUTHORITY: **CMA** FIELD BOOK:

Station Diagram
 Not to Scale
 North

STATION **DE SALIS GS^N 1814**


Current Occupant:
 Address:
 Phone:

ACCESS

Access Report of 15-1-1979 was found suitable/unsuitable.

Owner's Name:
 Address:
 Phone: 15-1-1979

Take 1:25000 map when printed.
 Upon reaching locked gate keep going
 far about 400m past gate to the end
 of the fence line & drive around
 fence line. & back onto track.
 Approx 20min walk from where you
 leave vehicle.
 1:100000 map would be useful.

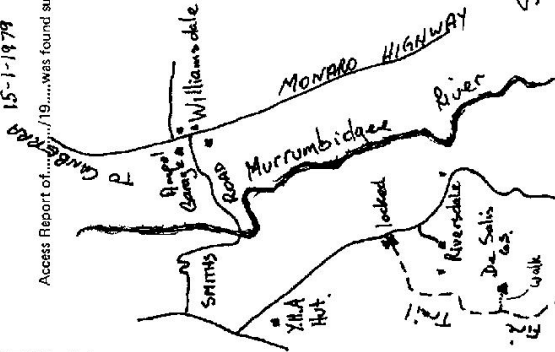

Scale Approx 1:100000

Record of Station

Date

15-1-79 Visited WRMiller

By 2733-2 D. West, Government Printer

Beacon Diagram	Not to Scale
	NO mast
	No vanes
	Carm 2m high
	2m dia

This section to be completed by officer constructing pillar.

Original station mark found/not found.

Description of mark:

Original beacon found/not found.

Description of beacon:

Height Top of Vanes to Top Markm.

Height of markm. above G.L. below

Diameter of Vanesm. Height of Carmm.

Original Beacon has/has not been destroyed by me.