


STATION DILGA T.S. 1829  
 Co: GORDON | PH. WARRABERRY  
 Map Sheet: CUNNOCK 150,000 | No: 8632-S  
 Inspected by: J. SHERWIN | Date: 10/3/77  
 Authority: C.M.A. | Field Book:

Beacon Diagram  
 Not to Scale

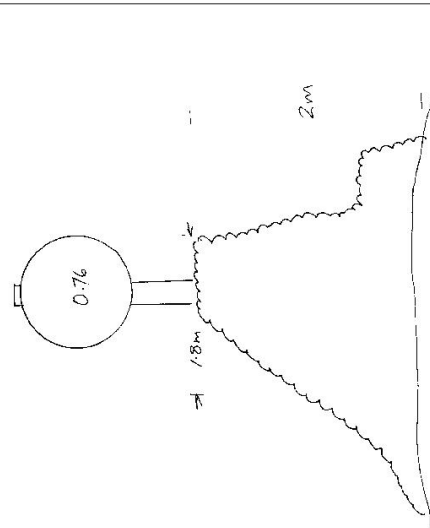

Date	Record of Station

Checked

This Trig. Station has been:-  
 Note: Cross out word or words which do not apply

1. Completely cleared to permit 360° vision to surrounding Trigs.
2. Cleared by lances bearing..... from Trig. Mast
3. Trig. Mast & Vanes have been painted white & black respectively.
4. The Trig. was unpiled/not unpiled, dimensions now being:
  - Description of mark..... should be explicit, e.g. Steel plug, Brass plug, Bolt, G.I. Pipe
  - Height of mark..... m above rock/concrete..... m above G.L.
  - Height of Top Vanes to Top Mark..... m. Diameter of Vanes (vertical)..... m.
  - Height of Cairn..... m. Diameter of Cairn..... m.

5. A..... set in conc/rock has been placed..... m. bearing.....°M from Trig. Mast
6. A..... set in conc/soil has been placed..... m. bearing.....°M from Trig. Mast
7. A..... set in conc/soil has been placed..... m. bearing.....°M from Trig. Mast
8. A..... set in conc/rock has been placed..... m. bearing.....°M from Trig. Mast
9. Connection..... to..... m. bearing.....°M
10. Connection..... to..... m. bearing.....°M
11. Connection..... to..... m. bearing.....°M
12. Connection..... to..... m. bearing.....°M
13. Diff. Ht. .... is..... m. above/below
14. Diff. Ht. .... is..... m. above/below
15. Diff. Ht. .... is..... m. above/below
16. Diff. Ht. .... is..... m. above/below

Noted on U.T.M. Card

Prepared by: J. Sherwin 2/1/77 Checked:

