

74598


CENTRAL MAPPING AUTHORITY
Department of Lands
Trigonometrical Survey of N.S.W.

RECONNAISSANCE and MAINTENANCE REPORT

STATION **DINGO G.S TS 1831**

Co: _____ Ph: _____
Map Sheet: **WINDHAM** No: **9334**
Inspected by: **K. HARRISON** Date: **7-10-77**
Authority: **CMA** Field Book: **1523**

Beacon Diagram Not to Scale

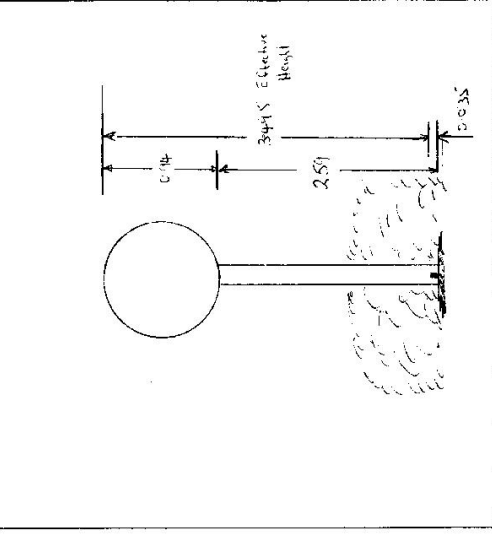

Date	Record of Station

This Trig. Station has been: Note: Cross out word or words which do not apply

- 1. Completely cleared to permit 360° vision to surrounding Trigs.
- 2. Cleared by lances bearing _____ from Trig. Mast
- 3. Trig. Mast & Vanes have been painted white & black respectively.
- 4. The Trig. was unpiled/not unpiled, dimensions now being: _____

Description of mark _____ should be explicit, e.g. Steel plug, Brass plug, Bolt, G.I. Pipe
 Height of mark _____ m ^{above}/_{below} _____ m ^{above}/_{below} G.L.
 Height of Top Vanes to Top Mark **34.15** m ✓ Diameter of Vanes (vertical) **0.94** m. ✓
 Height of Cairn **1** m. Diameter of Cairn _____ m.

- Length of Mast **3.59** m. (approximate if not unpiled)
- 5. **A.S.M.** set in conc/rock has been placed **4.35** m. bearing **116** °M from Trig. Mast
- 6. **G.I. Pipe** set in conc/soil has been placed **4.06** m. bearing **13** °M from Trig. Mast
- 7. **A.** set in conc/soil has been placed _____ m. bearing _____ °M from Trig. Mast
- 8. **A.** set in conc/rock has been placed _____ m. bearing _____ °M from Trig. Mast
- 9. Connection **G.I. Pipe to S.S.M.** : **6.54** m. bearing **153** °M
- 10. Connection _____ to _____ m. bearing _____ °M
- 11. Connection _____ to _____ m. bearing _____ °M
- 12. Connection _____ to _____ m. bearing _____ °M
- 13. Diff. Ht. **S.S.M** is **0.327** m. ^{above}/_{below} **TRIG. P.V.C.**
- 14. Diff. Ht. **S.I. Pipe** is **0.180** m. ^{above}/_{below} **TRIG. P.V.C.**
- 15. Diff. Ht. _____ is _____ m. ^{above}/_{below} _____
- 16. Diff. Ht. _____ is _____ m. ^{above}/_{below} _____

Prepared by: **K.D. HARRISON** Checked: _____ Noted on U.T.M. Card

STATION INGO TS-1831

Owners Name.....


Address.....

Access.....

- 7-10-1977
- 0.00 / Mount GEORGE Post Office. Proceed West
- 4.1 / Turn Right onto Knudsthal Forest Road
- 5.8 / Take Left fork
- 9.9 / Turn hard right onto Keppis Road
- 10.0 / Straight ahead
- 11.1 / Take Right fork
- 11.5 / Take Left Track
- 11.6 / Take left Track } Reverse vehicle up this slope for ease of re-packing.
- 11.7 / Leave vehicle.

Continue walking up spur to change of grade and then heel slightly right keeping two rocky knobs on your left, thence up gully to narrow rocky spur Proceed easterly along rocky spur to Trig.

Station Diagram Not to Scale

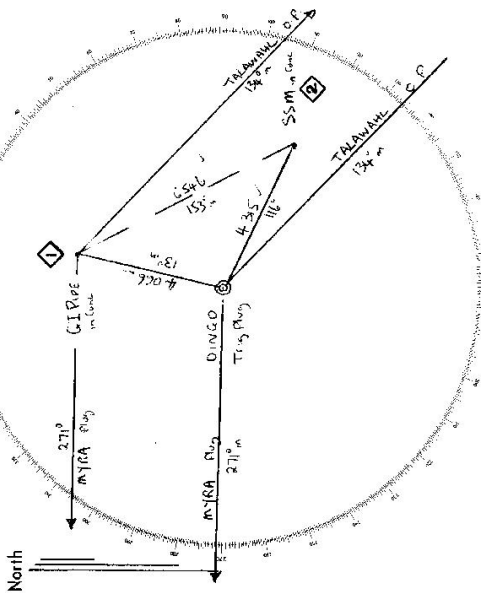

List of Observed Directions:-

Station	Direction	Station	Direction
TALAWALE	0° 00' 00"	TALAWALE	0° 00' 00"
MIRA	136° 51' 17"	SSM	19° 07' 00"
G. I. P. Pipe	341° 50' 00"	Peak Trig	58° 00' 30"
SSM	341° 50' 00"	MIRA	136° 50' 45"

Station	Direction	Station	Direction