

Department of Lands

T.S. 1839

Central Mapping Authority

Trigonometrical Survey of N.S.W.

RECONNAISSANCE and MAINTENANCE REPORT on DJARRA TRIG. STATION

District COWAN County CUMBERLAND Map Sheet SYDNEY No. 2130

Inspected by P. HANNA Date of Inspection 21.7.77

This Trig. Station has been:-

Note: Cross out word or words which do not apply

1. Completely cleared to permit 360° vision to surrounding Trigs.
2. Cleared by lanes bearing from Trig. Mast
3. The Trig. was ~~unpiled~~/not unpiled. dimensions now being:

Original Trig. Plug was found/not found.

Length of Mast 1.8 metres feet (approximate if not unpiled) Mast (Round 9cms feet diameter
(Square 9cms feet

Height of Trig. Plug feet (above rock/concrete) Diameter of Vanes (vertical) 0.6 feet


Height of Top Vanes to Top Trig. Plug feet

Height of Cairn 1.4 metres feet Diameter of Cairn feet

(If other type Trig. beacon is erected - Diagram is required below in Remarks)

4. Trig. Mast & Vanes have been painted white & black respectively.
5. An S.S.M. set in conc/rock has been placed feet bearing° M to Trig. Mast/Plug
6. G.I. Pipe set in conc/soil has been placed feet bearing° M to Trig. Mast/Plug
7. Connection S.S.M. to G.I. Pipe feet bearing° M

REMARKS:- (To include diagram of marks placed)

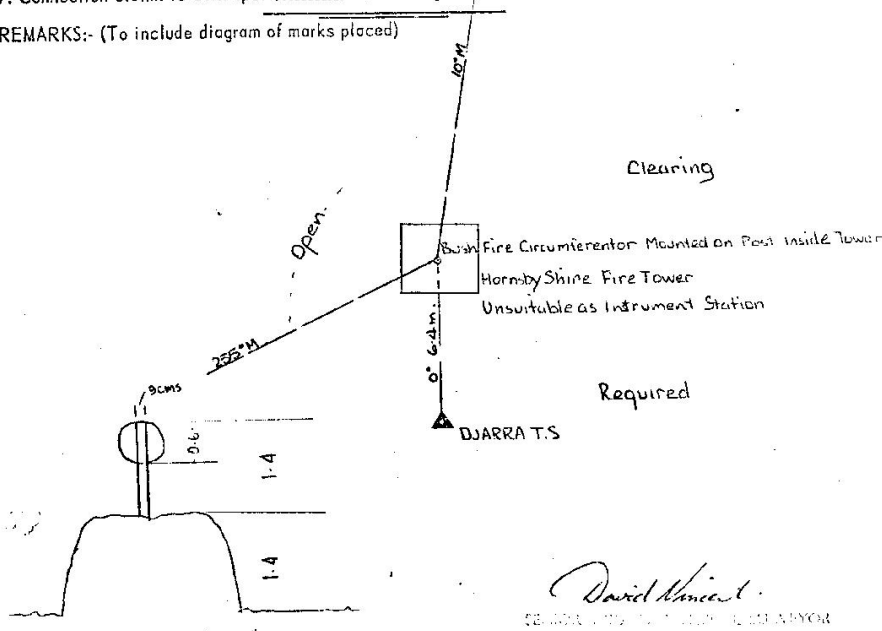

Clearing

Required

Bush Fire Circumferator Mounted on Post inside Tower
Hornby Shine Fire Tower
Unsuitable as Instrument Station

DJARRA T.S.

David Vincent

Senior Surveyor, Central Mapping Authority


21.7.77

DE NOTED: MICHAEL MURPHY,

21.7.77

Signature

Access. Djarra T.S. 1839

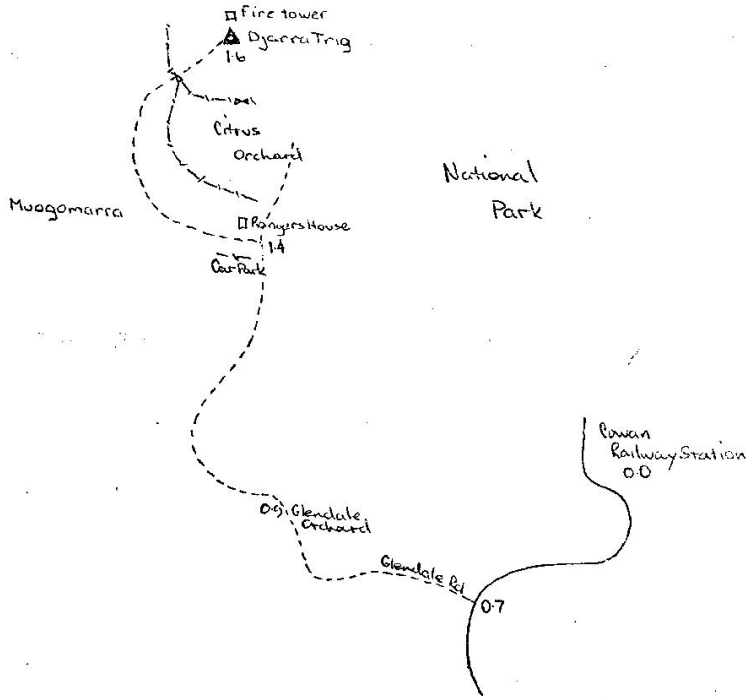

David Vincent

SENIOR SURVEYOR

2. 9. 1973

8 NOV 1973: MICHAEL MURPHY

20. 11. 1973