

RECONNAISSANCE and MAINTENANCE REPORT

TS 1844
STATION DODDS LAGOON

This Trig. Station has been:

Note: Cross out word or words which do not apply

1. Completely cleared to permit 360° vision to surrounding Trigs.

2. Cleared by lances bearing See Over from Trig. Mast

3. Trig. Mast & Vanes have been painted white & black respectively.

4. The Trig. was unpiled/not unpiled, dimensions now being: Original Station Mark found / not found

Description of mark: Stainless Steel Pin in Concrete Block should be explicit, e.g. Steel plug, Brass plug, Bolt, G.I. Pipe

Height of mark m ^{above} m ^{below} rock/concrete m ^{above} m ^{below} G.L.

Height of Top Vanes to Top Mark m. Diameter of Vanes (vertical) 0.61 m.

Height of Cairn m. Diameter of Cairn m.

Length of Mast m. (approximate if not unpiled)

5. A set in conc/rock has been placed m. bearing °M from Trig. Mast

6. A set in conc/soil has been placed m. bearing °M from Trig. Mast

7. A set in conc/soil has been placed m. bearing °M from Trig. Mast

8. A set in conc/rock has been placed m. bearing °M from Trig. Mast

9. Connection to : m. bearing °M

10. Connection to : m. bearing °M

11. Connection to : m. bearing °M

12. Connection to : m. bearing °M

13. Diff. Ht. is m. ^{above} m. ^{below}

14. Diff. Ht. is m. ^{above} m. ^{below}

15. Diff. Ht. is m. ^{above} m. ^{below}

16. Diff. Ht. is m. ^{above} m. ^{below}

Prepared by:

Checked:

Noted on U.T.M. Grid

Co: CAMDEN Ph: YARRAWA


Map Sheet: KANGAROO VALLEY C.M.A. 1:25000 No: 9028 (V-S)

Inspected by: Date: 1965

Authority: M.W.S. & D.B. Field Book:

Beacon Diagram

Not to Scale

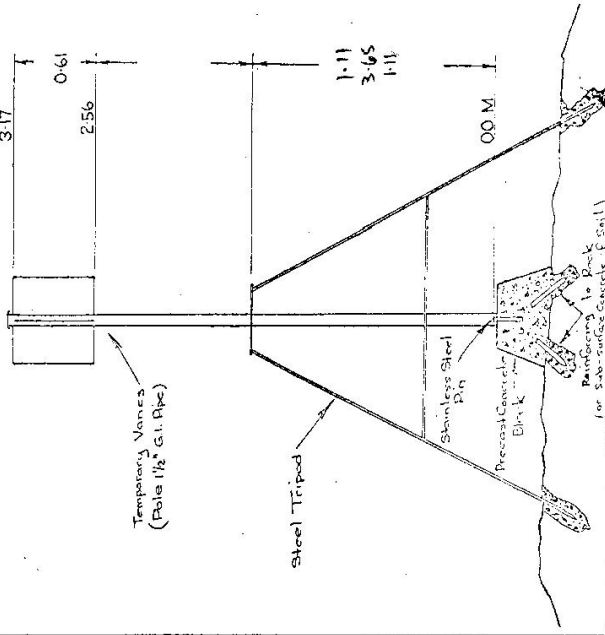

Date

Record of 1965

STATION **DODDS LAGOON TS-1844**

Owners Name.....


Address.....

City.....

A.M.....

Access
(cont) 1916

Not to Scale

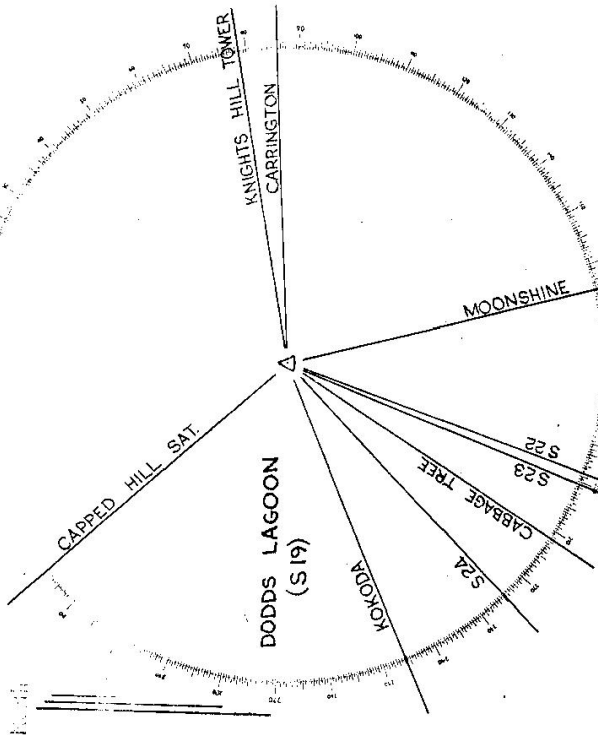

List of Observed Directions:

Station: DODDS LAGOON

Station	Direction
CARRINGTON	S18 0° 00' 00.00"
MOONSHINE	S20 78° 28' 33.72"
S22	S22 112° 40' 00.16"
S23	S23 114° 28' 23.91"
CABBAGE TREE	S26 125° 38' 23.37"

Station	Direction
S24	S24 139° 17' 07.78"
KOKODA	S21 160° 13' 09.44"
CAPPED HILL SAT.	S15 230° 47' 14.97"
KNIGHTS HILL TWR.	S11 352° 41' 56.94"

MEAN D SETS (1 SET - FLTP)

