

CENTRAL MAPPING AUTHORITY

GEODETIC SURVEY OF N.S.W.


GEODETIC STATION RECONNAISSANCE and MAINTENANCE REPORT

STATION: **DORA [P]** No.: **TS 1857**

MAP SHEET
SCALE 1:250 000

INSPECTED BY: **K. BRIDGES** DATE: **21.8.78**

AUTHORITY: **D.M.R.** FIELD BOOK:

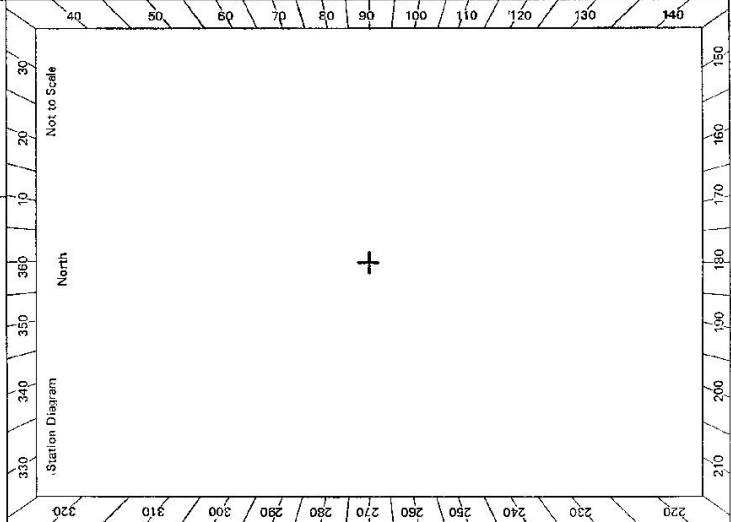

Description: *Note: Cross out word or words which do not apply*

1. Cleared by lanes bearing..... from Trig. Mast
2. Mast & Vanes have been painted white & black respectively.
3. The station/pillar was unpiled/not unpiled/constructed on.....19....., dimensions now being:
Description of mark.....should be explicit, e.g. S/Steel Pillar Plate, Steel plug, Brass plug, Bolt, G.I. Pipe
Height of mark.....m. ^{above} _{below} rock/concrete; Mark is.....m. ^{above} _{below} G.L.
- Height of Top Vanes to Top Mark/Pillar plate.....m. Diameter of Vanes (vertical).....m.
- Height of Cairn.....m. Diameter of Cairn.....m. Name Plate found/not found/placed.
- Length of Mast.....m. (approximate if not unpiled)
4. A.....set in conc/rock has been placed/found/bearing.....°M from Mast/Plug/Pillar
5. A.....set in conc/rock has been placed/found/bearing.....°M from Mast/Plug/Pillar
6. A.....set in conc/rock has been placed/found/bearing.....°M from Mast/Plug/Pillar
7. A.....set in conc/rock has been placed/found/bearing.....°M from Mast/Plug/Pillar
8. Action required:.....

STANDPOINT:

Mark	Direction	Horiz. Distance	Height Difference	Mark	Direction	Horiz. Distance	Height Difference
			above standpt.				above standpt.
			below standpt.				below standpt.
			above standpt.				above standpt.
			below standpt.				below standpt.
			above standpt.				above standpt.
			below standpt.				below standpt.
			above standpt.				above standpt.
			below standpt.				below standpt.

STANDPOINT:

Mark	Direction	Horiz. Distance	Height Difference
			above standpt.
			below standpt.
			above standpt.
			below standpt.
			above standpt.
			below standpt.
			above standpt.
			below standpt.

Prepared by: **KEN BRIDGES**

Checked: **R. Pierce**

Noted on U.T.M. Card

Checked

CENTRAL MAPPING AUTHORITY

GEODETTIC SURVEY OF N.S.W.

GEODETTIC STATION RECONNAISSANCE and MAINTENANCE REPORT


STATION: **DORA (P)** No.: **1857**

MAP SHEET SCALE 1:250 000

INSPECTED BY: **M. Morrison** DATE: **22-2-90**

AUTHORITY: **CMA** FIELD BOOK: **—**

- Description:
- Cleared by lanes bearing..... *Note: Cross out word or words which do not apply*
 - Mast & Vanes have been painted white & black respectively, from Trig. Mast
 - The station/pillar was unpiled/not unpiled/constructed on..... 19....., dimensions now being:
 Description of mark.....should be explicit, e.g., S/Steel Pillar Plate, Steel plug, Brass plug, Bolt, G.I. Pipe
 - Height of mark.....m. ^{above} rock/concrete; Mark is..... ^{above} G.L.
 Height of Top Vanes to Top Mark/Pillar plate.....m. ^{above} m. ^{below} Diameter of Vanes (vertical).....m.
 - Height of Cairn.....m. Diameter of Cairn.....m. Name Plate found/not found/placed.
 - Length of Mast.....m. (approx. made if ~~unpiled~~)
 - A.....set in conc/rock has been placed/found, bearing.....°M from Mast/Plug/Pillar
 - A.....set in conc/rock has been placed/found, bearing.....°M from Mast/Plug/Pillar
 - A.....set in conc/rock has been placed/found, bearing.....°M from Mast/Plug/Pillar
 - A.....set in conc/rock has been placed/found, bearing.....°M from Mast/Plug/Pillar
 - Action required:.....

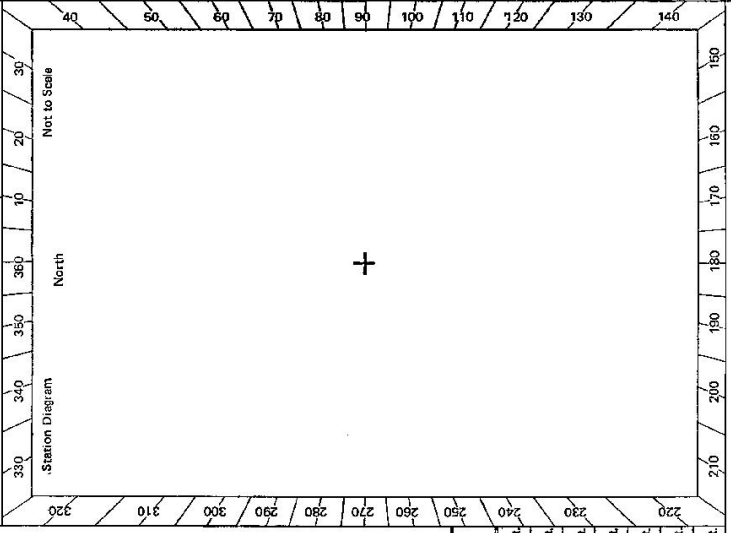

STANDPOINT:			
Mark	Direction	Horiz. Distance	Height Difference
			above standpt.
			below standpt.
			above standpt.
			below standpt.
Prepared by: **AS** *Checked* **SJA** *Noted on U.T.M. Card*

GS 24

STATION DORA (P) TS-1857	Owner's Name: Address: Phone: Current Occupant: Address: Phone: DATE: FEB 1990 ACCESS 2WD Access Report of Feb 1990 was found suitable/unstable. 0.0 MORISSET P.O. Head north towards TORONTO 0.92 Turn Right towards "MORISSET EAST 2" 2.81 Turn Left sign "FISHERY POINT ROAD" 7.36 DORA (P) at reservoir on R.H.S. DATE 22.2.90
Beacon Diagram Not to Scale	This section to be completed by officer constructing pillar. Original station mark found/not found. Description of mark: Original beacon found/not found. Description of beacon: Height Top of Vanes to Top Markm. Height of markm above rock/contcm above G.L. Diameter of Vanesm belowm below Height of Cairnm. Original Beacon has/has not been destroyed by me.
Date	Record of Station