

CENTRAL MAPPING AUTHORITY

GEODETIC SURVEY OF N.S.W.

GEODETIC STATION RECONNAISSANCE and MAINTENANCE REPORT

Description:

Note: Cross out word or words which do not apply

- Cleared by lanes bearing..... from Trig. Mast
- Mast & Vanes have been painted white & black respectively.
- The station/pillar was unpiled/not unpiled/constructed on..... 19....., dimensions now being: Description of mark.....should be explicit, e.g., S/Steel Pillar Plate, Steel plug, Brass plug, Bolt, G.I. Pipe
- Height of mark.....m. above rock/concrete; Mark is.....m. above G.L.
- Height of Top Vanes to Top Mark/Pillar plate.....m. Diameter of Vanes (vertical).....m.
- Height of Cairn.....m. Diameter of Cairn.....m. Name Plate found/not found/placed.
- Length of Mast.....m. (approximate if not unpiled)
- A.....set in conc/rock has been placed/found, bearing.....° M from Mast/Plug/Pillar
- A.....set in conc/rock has been placed/found, bearing.....° M from Mast/Plug/Pillar
- A.....set in conc/rock has been placed/found, bearing.....° M from Mast/Plug/Pillar
- A.....set in conc/rock has been placed/found, bearing.....° M from Mast/Plug/Pillar

8. Action required:..... Station to be piled, either roof top, or concrete depending

STANDPOINT:

STANDPOINT: on access

Mark	Direction	Horiz. Distance	Height Difference	Merk	Direction	Horiz. Distance	Height Difference
			above standpt.				above standpt.
			below				below
			above standpt.				above standpt.
			below				below
Prepared by:

Checked:

Noted on U.T.M. Card

SR 2733-1

STATION: **DOWD** No.: **1868**

MAP SHEET SCALE 1:250 000 **DUBBO**

INSPECTED BY: **G. Jones** DATE: **23/6/81**

AUTHORITY: **CMA** FIELD BOOK: **1915**

Station Diagram North Not to Scale


Very wide flat hill. Small but dense scrub covers hill. With clearings would have good views in all directions. (Lanes only?)

Checked

Prepared by: **GL** 20/7/81

Checked: **K Ludwig** 21-7-81

SI 2733-2 D. West, Government Printer

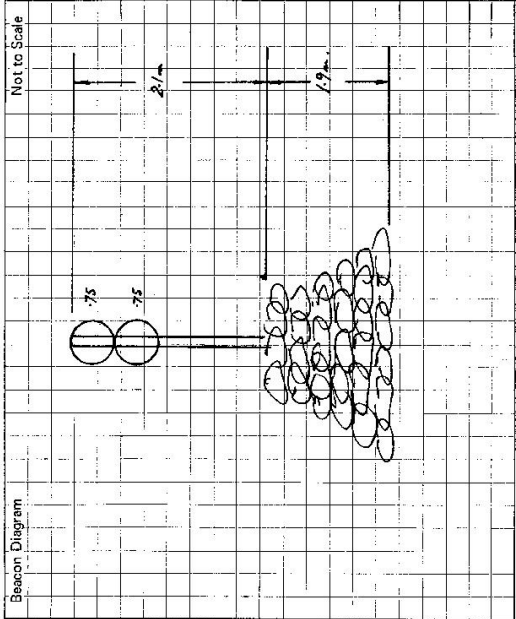

This section to be completed by officer constructing pillar.

Original station mark found/not found.
 Description of mark:
 Original beacon found/not found.
 Description of beacon:
 Height Top of Vanes to Top Markm.
 Height of markm. above / below G.L.
 Diameter of Vanesm. Height of Cairnm.
 Original Beacon has/has not been destroyed by me.

STATION DOWD TS 1868

Owner's Name: TR 36036
 Address: Conditional lease
 Phone: Mr. Hyland

Access through: Mr Cyril Hyland
 Address: KARINGALE
 Phone: See access 877 934

ACCESS

Access Report of 21.6.1981 was found suitable/unsuitable.

- 0-0 Major intersection at western end of bridge over the Macquarie River in Dubbo. Travel towards Parkes along the Newell Hwy. Sign: Obey S, Yeoval 69.
- 2-35 Turn left at western Plains Zoo. Sign: Obey S, Yeoval 69.
- 10-6 Railway crossing.
- 11-45 Take right fork. Sign: Obey Road.
- 17-0 Railway crossing.
- 23-9 Turn left. Sign: "Toongi"
- 24-3 Over causeway then turn right.
- 28-9 Turn left.
- 30-8 Railway crossing.
- 32-45 Turn left through iron gates into "KARINGALE"

- 34-2 Drive past left hand side of the older house, then through iron gates at 34-1.
- 34-65 Drive through two gates on left, towards hill. 20 m easy walk from this point

Possible to drive a lot further, see owner regarding an old track.

Date	Record of Station