

CENTRAL MAPPING AUTHORITY

GEODETIC SURVEY OF M.S.W

GEODETIC STATION RECONNAISSANCE and MAINTENANCE REPORT

STATION: DRINA No: 1875

MAP SHEET SCALE 1:250 000 CAN/BE RRA

INSPECTED BY: K HADJOU DATE: 17 Oct. 1979

AUTHORITY: CAN A FIELD BOOK:

Description: *Note: Cross out word or words which do not apply*

- 1. Cleared by lanes bearing..... from Trig. Mast
- 2. Mast & Vanes have been painted white & black respectively.
- 3. The station/pillar was unpiled/not unpiled/constructed on..... 19....., dimensions now being: Description of mark..... should be explicit, e.g., S/Steel Pillar Plate, Steel plug, Brass plug, Bolt, G.I. Pipe
 Height of mark.....m. ^{above} _{below} rock/concrete; Mark is.....m. ^{above} _{below} G.L.
 Height of Top Vanes to Top Mark/Pillar platem. Diameter of Vanes (vertical).....m.
 Height of Cairn.....m. Diameter of Cairn.....m. Name Plate found/not found/placed.
 Length of Mastm. (approximate if not unpiled)
- 4. A.....set in conc/rock has been placed/found, bearing.....° M from Mast/Plug/Pillar
- 5. A.....set in conc/rock has been placed/found, bearing.....° M from Mast/Plug/Pillar
- 6. A.....set in conc/rock has been placed/found, bearing.....° M from Mast/Plug/Pillar
- 7. A.....set in conc/rock has been placed/found, bearing.....° M from Mast/Plug/Pillar
- 8. Action required:.....


STANDPOINT:

Mark	Direction	Horiz. Distance	Height Difference	Mark	Direction	Horiz. Distance	Height Difference
			above standpt.				above standpt.
			below standpt.				below standpt.
			above standpt.				above standpt.
			below standpt.				below standpt.
Prepared by: K. Hadjou



Checked: _____

SI 2733-1

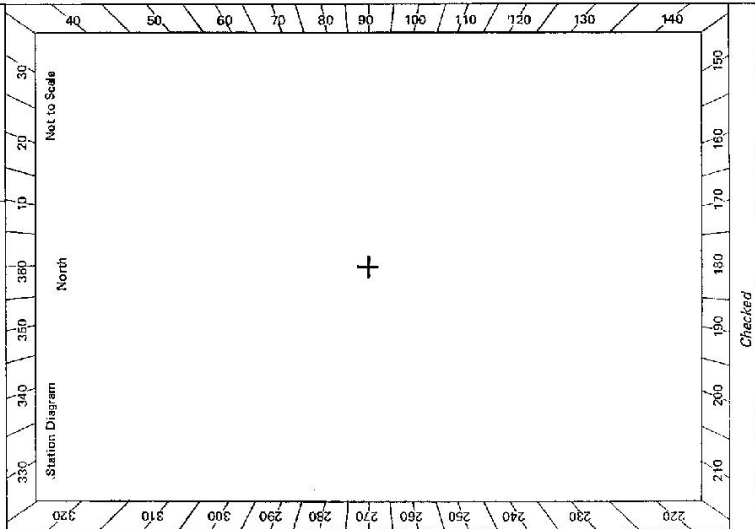

STATION DRINA TS 1875

SR 2733-2 D. West. Government Printer

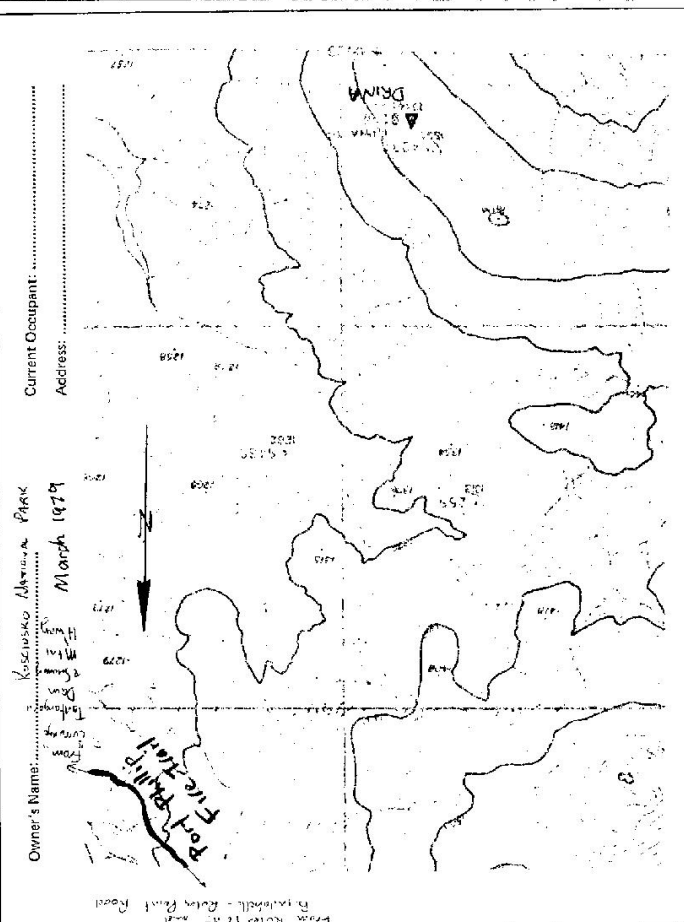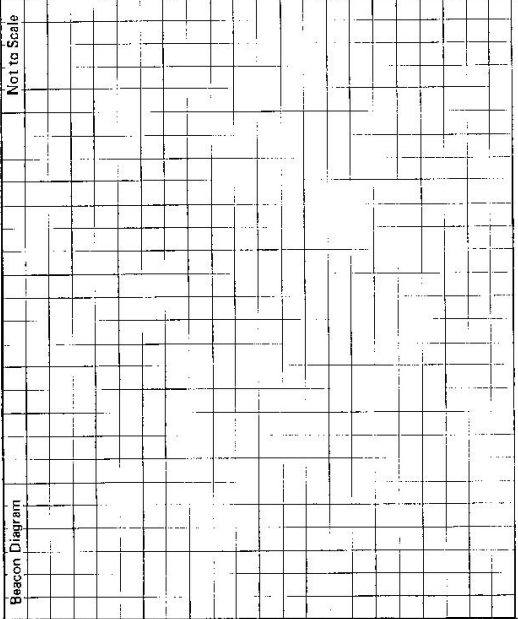

This section to be completed by officer constructing pillar.

Original station mark found/not found.

Description of mark:

Original beacon found/not found.

Description of beacon:

Height Top of Varies to Top Mark.....m.
 Height of mark.....m. above G.L. below
 rock/conc.....m. below

Diameter of Variesm. Height of Cairnm.

Original Beacon has/has not been destroyed by ma.

Date	Record of Station
March 1979	Beacon sighted from road approx 3km North of station.