

CENTRAL MAPPING AUTHORITY

GEODETIC SURVEY OF M.S.W.

GEODETIC STATION RECONNAISSANCE and MAINTENANCE REPORT


STATION: DROGHEDA No.: 1876

MAP SHEET SCALE 1:250 000 BATHURST

INSPECTED BY: G. C. HANNA DATE: 5/6/79

AUTHORITY: C. M. A. FIELD BOOK:

- Description:
- Note: Cross out word or words which do not apply from Trig. Mast*
1. Cleared by lanes bearing.....
 2. Mast & Vanes have been painted white & black respectively.
 3. The station/pillar was unplied/not unplied/constructed on.....19..... dimensions now being:
Description of mark.....should be explicit, e.g., S/Steel Pillar Plate, Steel plug/Brass plug, Bolt, G.I. Pipe
Height of mark.....m, above below rock/concrete; Mark is.....m above below G.L.
 4. A.....set in conc/rock has been placed/found, bearing.....° M from Mast/Plug/Pillar
 5. A.....set in conc/rock has been placed/found, bearing.....° M from Mast/Plug/Pillar
 6. A.....set in conc/rock has been placed/found, bearing.....° M from Mast/Plug/Pillar
 7. A.....set in conc/rock has been placed/found, bearing.....° M from Mast/Plug/Pillar
 8. Action required:.....

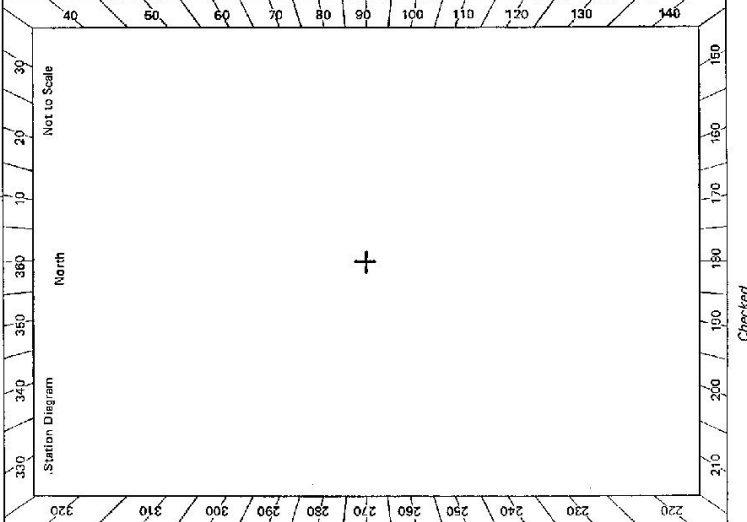

STANDPOINT:

Mark	Direction	Horiz. Distance	Height Difference	Mark	Direction	Horiz. Distance	Height Difference
			above standpt.				above standpt.
			below				below
			above standpt.				above standpt.
			below				below
Noted on U.T.M. Card

Prepared by: *G. Hanna* 26/6/79 Checked:

