

CENTRAL MAPPING AUTHORITY

Department of Lands

Trigonometrical Survey of N.S.W.

RECONNAISSANCE and MAINTENANCE REPORT

This Trig. Station has been:-

Note: Cross out word or words which do not apply

- Completely cleared to permit 360° vision to surrounding Trigs.
- Cleared by lanes bearing..... from Trig. Mast
- Trig. Mast & Vanes have been painted white & black respectively.
- The Trig. was unspiled/not unspiled, dimensions now being: Original ~~3.0m~~ ^{3.0m} above G.L. ~~1.5m~~ ^{1.5m} below G.L.

Description of mark..... should be explicit, e.g. Steel plug, Brass plug, Bolt, G.I. Pipe

Height of mark..... m above rock/concrete

..... m above G.L.

Height of Top Vanes to Top Mark..... m. Diameter of Vanes (vertical)..... m.

Height of Cairn..... m. Diameter of Cairn..... m.

Length of Mast..... m. (approximate if not unspiled)

- A..... set in conc/rock has been placed..... m. bearing.....°M from Trig. Mast
- A..... set in conc./soil has been placed..... m. bearing.....°M from Trig. Mast
- A..... set in conc./soil has been placed..... m. bearing.....°M from Trig. Mast
- A..... set in conc/rock has been placed..... m. bearing.....°M from Trig. Mast

Connection..... to..... m. bearing.....°M

Connection..... to..... m. bearing.....°M

Connection..... to..... m. bearing.....°M

Connection..... to..... m. bearing.....°M

Diff. Hr. is..... m. above below

Diff. Hr. is..... m. above below

Diff. Hr. is..... m. above below

Diff. Hr. is..... m. above below

Prepared by: *J. Sherwin* 21/12/77 Checked:

Noted on U.T.M. Card

STATION DUCK T.S. 1885


Co: Ph:

Map Sheet: WIRBINYA 1:50 000 No. 8430-N

Inspected by: J. SHERWIN Date: 1/11/77

Authority: Field Book:

Beacon Diagram: Not to Scale

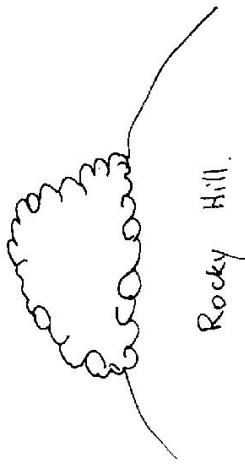

Date	Record of Station

Checked

