

CENTRAL MAPPING AUTHORITY

GEODETIC SURVEY OF M.S.W.

GEODETIC STATION RECONNAISSANCE and MAINTENANCE REPORT

Description:

1. Cleared by lanes bearing..... *Note: Cross out word or words which do not apply*

2. Mast & Vanes have been painted white & black respectively.

3. The station/~~pillar~~ was ~~unvisited~~/not unplied/~~concentrated~~ on..... 3.11..... 19.77....., dimensions now being:

Description of mark..... should be explicit, e.g., S/Steel Pillar Plate, Steel plug, Brass plug, Bolt, G.I. Pipe

Height of mark.....m. ^{above} rock/concrete; Mark ism. ^{above} G.L.

Height of Top Vanes to Top Mark/Pillar platem. Diameter of Vanes (vertical).....m.

Height of Cairn.....m. Diameter of Cairn.....m. Name Plate found/not found/placed.

Length of Mastm. (approximate if not unplied)

4. A..... set in conc/rock has been placed/found, bearing.....° M from Mast/Plug/Pillar

5. A..... set in conc/rock has been placed/found, bearing.....° M from Mast/Plug/Pillar

6. A..... set in conc/rock has been placed/found, bearing.....° M from Mast/Plug/Pillar

7. A..... set in conc/rock has been placed/found, bearing.....° M from Mast/Plug/Pillar

8. Action required:..... *BEACON IN POOR CONDITION - REQUIRES REPLACEMENT.*

STANDPOINT:

STANDPOINT:

Mark	Direction	Horiz. Distance	Height Difference	Mark	Direction	Horiz. Distance	Height Difference
			above standpt.				above standpt.
			below				below
			above standpt.				above standpt.
			below				below
Prepared by: *Thelma*Checked: *9.8.78*

Notes on U.T.M. Card

St 2733-1

STATION: <i>DUMOSS A</i>	No.: <i>TS 1896</i>
MAP SHEET SCALE 1:250 000	
INSPECTED BY: <i>P. N. S. G. R.</i>	DATE: <i>3.11.77</i>
AUTHORITY:	FIELD BOOK:

DUMOSSA
15 1896


Current Occupant: "The Ranch"
Address: (See below)
Phone:

Owner's Name: TRIG RESERVE
Address:
Phone:

ACCESS

Access Report of 3/11/1977... was found suitable/unsuitable.
NARRANDEA 1: 250,000 Map Reference

390/798

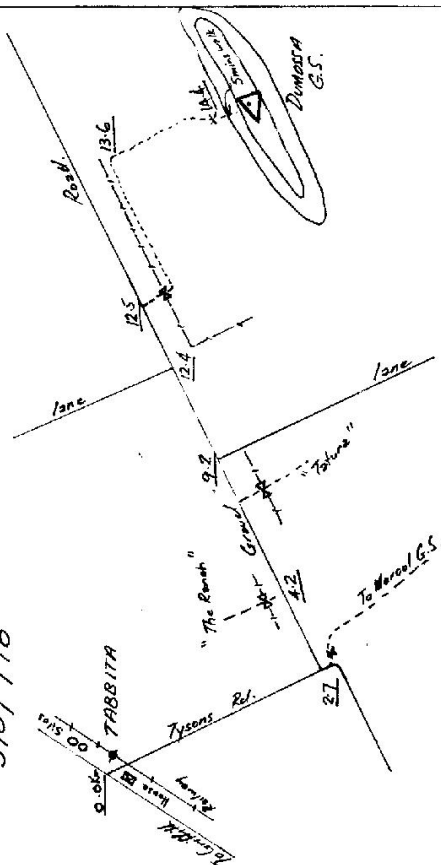

Record of Station

Date _____

This section to be completed by officer constructing pillar.

Original station mark found/not found.

Description of mark:

Original beacon found/not found.

Description of beacon:

Height Top of Vanes to Top Markm.

Height of mark.....m.	above below	rock/conc.....m.	above below	G.L.
-----------------------	----------------	------------------	----------------	------

Diameter of Vanesm.
Height of Cairnm.

Original Beacon has/has not been destroyed by me.