

CENTRAL MAPPING AUTHORITY  
Department of Lands

Trig Station Survey of N.S.W.

RECONNAISSANCE and MAINTENANCE REPORT

This Trig. Station has been:

Note: Cross out word or words which do not apply

1. Completely cleared to permit 360° vision to surrounding Trig.
2. Cleared by lances bearing 235° M. from Trig. Mast Plus
3. Trig. Mast & Vanes have been painted white & black respectively.
4. The Trig. was unpainted/not unpainted, dimensions now being:
  - Description of mark BRASS PIPE should be explicit, e.g. Steel plug, Brass plug, Bolt, G.I. Pipe
  - Height of mark 0.03 m above rock/concrete 0.04 m below G.L.
  - Height of Top Vanes to Top Mark          m Diameter of Vanes (vertical)          m
  - Height of Centre          m Diameter of Centre          m
  - Length of Mast          m (approximate if not unpainted)
5. PM16539 set in conc/rock has been placed. 48.516 m. bearing 125° M from Trig. Mast
6. PM16540 set in conc/soil has been placed. 44.404 m. bearing 142° M from Trig. Mast
7. A          set in conc/soil has been placed.          m. bearing         ° M from Trig. Mast
8. A          set in conc/rock has been placed.          m. bearing         ° M from Trig. Mast
9. Connection PM16539 to PM16540 16.610 m. bearing 238° M
10. Connection          to                   m. bearing         ° M
11. Connection          to                   m. bearing         ° M
12. Connection          to                   m. bearing         ° M
13. Diff. Ht. PM16539 is 0.17 m. TRIG. PLUS
14. Diff. Ht. PM16540 is 0.13 m. TRIG. PLUS
15. Diff. Ht.          is          m. above
16. Diff. Ht.          is          m. below

Prepared by: F. J. Sullivan

Checked: Robert Handley

Noted on U.T.M. Card

Checked

A.C. Edmunds 19/8/74

STATION ELIZA TS 1948

Co: CUMBERLAND Ph: GORDON

Map Sheet 5718/11 No: 423

Inspected by: F. SULLIVAN Date: 19.7.74

Authority LANDS DEPARTMENT Field Book:         

Beacon Diagram Not to Scale

NO BEACON OR PAIRN ON PILE

NOTE: ON SURFACE (VIEWED TO ALIGN)




Date

Record of Station

Non-Geodetic

STATION ELIZA TS 1948

Owners Name.....  
 Current Occupant.....  
 Address.....  
 Address.....

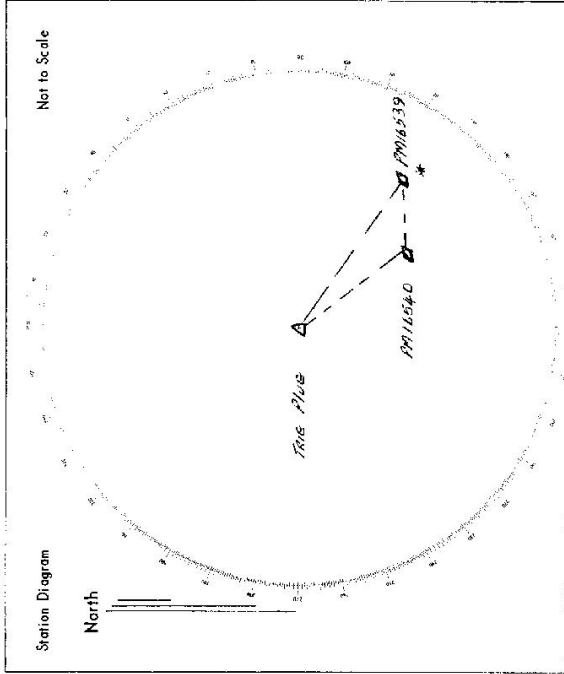

List of Observed Directions:-

Standpoint: PM16539		Standpoint: TRUE PLUG	
Station	Direction	Station	Direction
TRUE PLUG	0 00 00	PM16539	0 00 00
PM16540	294 05 48	PM16540	19 57 27
Standpoint: PM16539 (SEE ROSEBERRY A.Z.E.)			
Station	Direction	Station	Direction
DUPY near PM16537	0 00 00		
MM1	214 28 47		
BT16540	232 04 02		
MM2	259 06 04		

