

CENTRAL MAPPING AUTHORITY

GEODETIC SURVEY OF N.S.W.

GEODETIC STATION RECONNAISSANCE and MAINTENANCE REPORT

STATION: ELLEN DEN No.: 75 1951

MAP SHEET SCALE 1:250 000 CANBERRA

INSPECTED BY: H.C. BORDER DATE: 11.12.78

AUTHORITY: C.M.A. FIELD BOOK: 01411

Description: Note: Cross out word or words which do not apply
 1. Cleared by lanes bearing..... Cleared 360..... from Trig. Mast Plug

2. Mast & Vanes have been painted white & black respectively.

3. The station/pillar was unpiled/not-emptied/..... 19..... dimensions now being:

Description of mark: ~~Brass Plug~~ should be explicit, e.g. S/Steel Pillar Plate, Steel plug, Brass plug, Bolt, G.I. Pipe

Height of mark.....m. above rock/concrete; Mark is.....m. above G.L.

Height of Top Vanes to Top Mark/Pillar plate.....m. Diameter of Vanes (vertical).....m.

Height of Cairn.....m. Diameter of Cairn.....m. Name Plate found/not found/placed.

Length of Mast.....m. (approximate if not unpiled)

4. A. ~~no marks~~.....set in conc/rock has been placed/found, bearing.....°M from Mast/Plug/Pillar

5. A.....set in conc/rock has been placed/found, bearing.....°M from Mast/Plug/Pillar

6. A.....set in conc/rock has been placed/found, bearing.....°M from Mast/Plug/Pillar

7. A.....set in conc/rock has been placed/found, bearing.....°M from Mast/Plug/Pillar

8. Action required: ~~have Mast & Vanes to be guy wired down.~~

STANDPOINT:

STANDPOINT:


Mark	Direction	Horiz. Distance	Height Difference	Mark	Direction	Horiz. Distance	Height Difference
			above standpt.				above standpt.
			below				below
			above standpt.				above standpt.
			below				below
Prepared by: H.C. BORDER

Checked:


Noted on U.T.M. Card

Checked

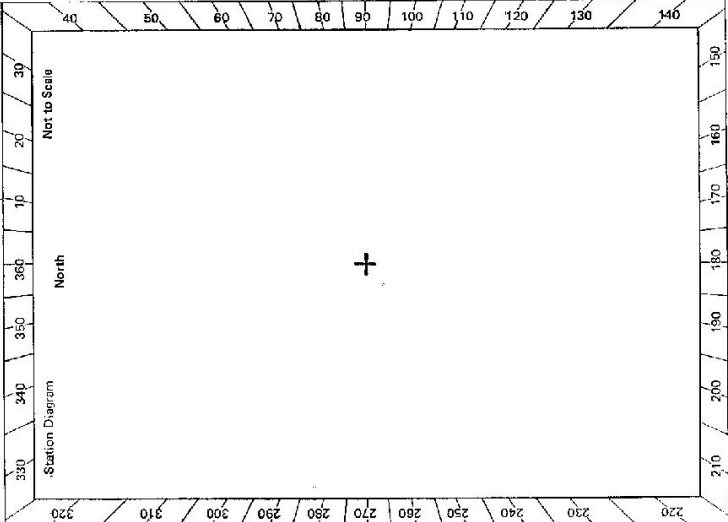

6: 2728-2 D. West, Government Printer

Beacon Diagram

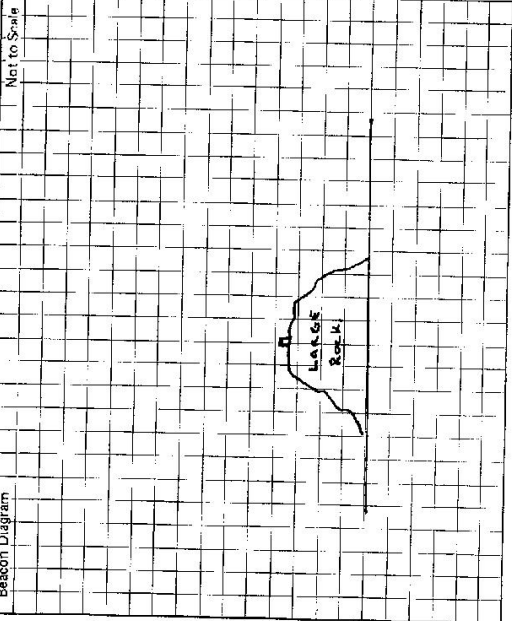

This section to be completed by officer constructing pillar.

Original station mark found/~~was~~found.

Description of mark: Bronze Plug in large rock

Original beacon ~~found~~/not found.

Description of beacon:

Height Top of Vanes to Top Mark.....m.

Height of mark.....m. ^{above} rock/~~above~~ G.L.

Diameter of Vanes.....m. Height of Cairn.....m.

Original Beacon ~~was~~/has not been destroyed by me.

STATION ELLENDEN JS 1951

Owner's Name:
 Address:
 Phone:
 Current Occupant:
 Address:
 Phone:

ACCESS

Access Report of 11.12.1978 was found suitable/unsuitable.

- Km's. Bungendore Post Office, travel west towards Gundaroo.
- 0.60. Turn right towards Goulburn (sign 6.68km).
- 7.20. Turn left. grid entrance to CUEBRANDDOOLEY.
- 7.40. Concessionary.
- 8.40. Straight ahead, grid.
- 9.80. grid.
- 10.30. Entrance to sand quarry on left. straight ahead.
- 11.30. Bridge over gully.
- 11.60. take left fork.
- 12.00. grid.
- 12.50. bridge.
- 12.60. take right fork. follows main track.
- 12.90. grid.
- 13.70. take left fork.
- 13.80. grid.
- 13.90. House on R.H.S owner. follow straight ahead.

Date

Record of Station

15.10. gate. head north towards water tank
15.50. Water tank. make way up steep ridge
15.80. top of ridge. turn west towards fence line.
16.10. fence line. 10 minutes walk to top of steep side. and along top of hill.