

CENTRAL MAPPING AUTHORITY

GEODETTIC SURVEY OF N.S.W.

GEODETTIC STATION RECONNAISSANCE and MAINTENANCE REPORT

STATION: **ENDRICK** No.: **1968**

MAP SHEET ULLADULLA

SCALE 1:250 000 INSPECTED BY: **J. JUDGE / R. ELLIS** DATE: **12-8-81**

AUTHORITY: **C. M. A.** FIELD BOOK: **L O 135**

Description: *Note: Cross out word or words which do not apply*

1. Cleared by vanes bearing..... *Not observed... but could be cleared 360° from Trig. Mast or levelled in some areas.*
2. Mast & Vanes have been painted white & black respectively. ✓
3. The station/pillar was ~~unpiled/constructed~~ on..... **12.2.8. m. 19.81. m.**, dimensions now being: Description of mark..... should be explicit, e.g., S/Steel Pillar Plate, Steel plug, Brass plug, Bolt, G.I. Pipe
- Height of mark..... m. ^{above} rock/concrete; Mark is..... m. ^{above} G.L.
- Height of Top Vanes to Top Mark/Pillar plate..... m. Diameter of Vanes (vertical)..... m.
- Height of Cairn..... m. Diameter of Cairn..... m. Name Plate found/not found/placed.
- Length of Mast..... m. (approximate if not unpiled)
4. A..... set in conc/rock has been placed/found, bearing..... °M from Mast/Plug/Pillar
5. A..... set in conc/rock has been placed/found, bearing..... °M from Mast/Plug/Pillar
6. A..... set in conc/rock has been placed/found, bearing..... °M from Mast/Plug/Pillar
7. A..... set in conc/rock has been placed/found, bearing..... °M from Mast/Plug/Pillar
8. Action required..... **SOME CLEARING REQUIRED - GOOD SITE FOR ROOFTOP PILLAR AFFIXED TO ROCK.**

STANDPOINT:


Mark	Direction	Horiz. Distance	Height Difference	Mark	Direction	Horiz. Distance	Height Difference
			above standpt				above standpt
			below				below
			above standpt				above standpt
			below				below
Prepared by: *MLL 23/9/81*

Checked:

Noted on U.T.M. Card

Checked 2/8/81

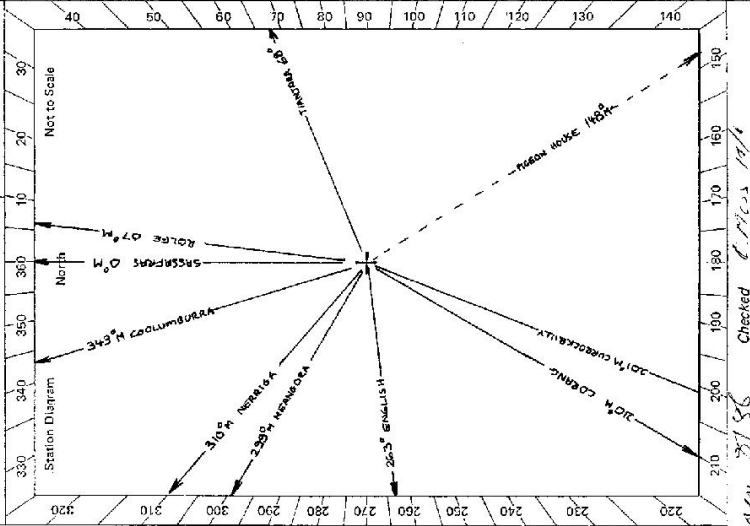

GS 24

STATION **ENDRICK TS 1968**

Owner's Name: **MORTON NATIONAL PARK**
 Address:
 Phone:
 Current Occupant:
 Address:
 Phone:

ACCESS

Access Report of **21.8.1981** was found suitable/unsuitable.
ACCESS FROM ACELRA

- 0.0 km ON RANGES HIGHWAY SOUTH OF NAJIRA
- 23.7 TURN RIGHT OPPOSITE "SEA VENOM" PLANE
- TOWARDS BARWOOD BARRIER. MAKE RIGHT TURN.
- 7.0 TURN RIGHT TOWARDS BARWOOD.
- 35.1 PASS "SQUATTAH" TALK ON LEFT.
- 47.80 TURN LEFT THROUGH IRON GATE - LARGE
- CORRALGATED IRON SHED ON LEFT.
- FOLLOW TRACK BETWEEN SHED AND OLD HUT
- 48.56 PASS TRACK THAT VEERS TO LEFT - SIGN "329.327"
- 49.15 IRON GATE AT TRANSMISSION LINE.
- 49.57 IRON GATE.
- 51.37 IRON GATE AND OLD GRID - PARK BOUNDARY
- 61.05 OLD WOODEN BRIDGE.
- 62.25 OLD WOODEN BRIDGE.
- 63.70 TAKE FANOUT TRACK ON LEFT NEAR PARK SIGN
- JUST AFTER COMING THROUGH RAINFOREST.
- 64.23 PARK TRUCK AT TOP OF RIDGE
- WALK ALONG SPUR AND MAKE DOWN WAY
- ONTO "CULTIES MOUNTAIN".
- * ABOUT A 45 MINUTE WALK WITH LIGHT
- LOAD.

Beacon Diagram

Not to Scale
CAIRN POLE & DISCS IN GOOD CONDITION

This section to be completed by officer constructing pillar.

Original station mark found/not found.

Description of mark:

Original beacon found/not found.

Description of beacon:

Height Top of Vane to Top Mark:m.

Height of mark:m. above G.L.,
 below

Diameter of Vane:m. Height of Cairnm.

Original Beacon has/has not been destroyed by me.

Date	Record of Station