

CENTRAL MAPPING AUTHORITY

GEODETIC SURVEY OF N.S.W.

GEODETIC STATION RECONNAISSANCE and MAINTENANCE REPORT

STATION: **ERIGOLIA** No.: **1976**

MAP SHEET SCALE 1:250 000 **CARGELLIGO**

INSPECTED BY: **G.C.HANNA** DATE: **15/5/79**

AUTHORITY: **C.M.A.** FIELD BOOK:

Description: *Note: Cross out word or words which do not apply*

1. Cleared by lanes bearing..... from Trig. Mast.

2. Mast & Vanes have been painted white & black respectively.

3. The station/pillar was unpiled/not unpiled/constructed on..... 19..... dimensions now being:
 Description of mark..... should be explicit, e.g., S/Steel Pillar Plate-Steel plug, Brass plug, Bolt, G.I. Pipe
 Height of mark.....m. ^{above} rock/concrete; Mark is.....m. ^{above} G.L.
 Height of Top Vanes to Top Mark/Pillar plate.....m. Diameter of Vanes (vertical).....m.
 Height of Cairn.....m. Diameter of Cairn.....m. Name Plate found/not found/placed.
 Length of Mast.....m. (approximate if not unpiled)


4. A..... set in conc/rock has been placed/found, bearing.....°M from Mast/Plug/Pillar

5. A..... set in conc/rock has been placed/found, bearing.....°M from Mast/Plug/Pillar

6. A..... set in conc/rock has been placed/found, bearing.....°M from Mast/Plug/Pillar

7. A..... set in conc/rock has been placed/found, bearing.....°M from Mast/Plug/Pillar


8. Action required:.....

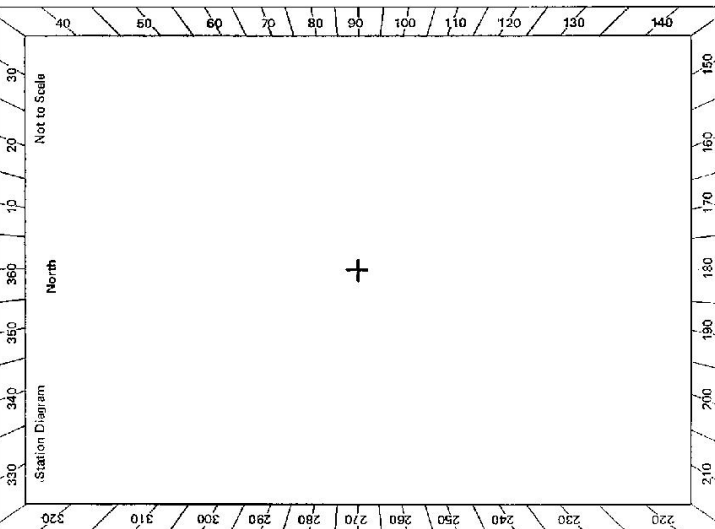

STANDPOINT:							
Mark	Direction	Horiz. Distance	Height Difference	Mark	Direction	Horiz. Distance	Height Difference
			above standpt.				above standpt.
			below standpt.				below standpt.
			above standpt.				above standpt.
			below standpt.				below standpt.
Prepared by: *G. Hanna* 15/5/79 Checked: *[Signature]* Noted on U.T.M. Chart

GS 24

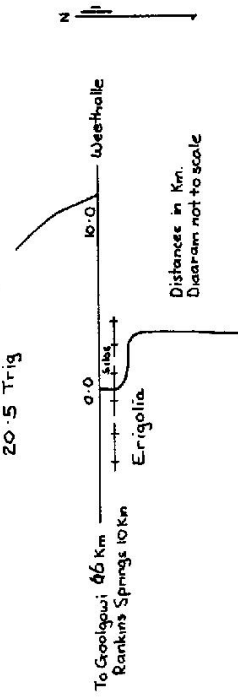STATION ERIGOLIA TS: 1976	Owner's Name: Address: Phone: Current Occupant: Address: Phone: ACCESS See Rankins Springs 8130-S Access Report of 15/10/1974 was found suitable/unavailable. Carrn, Mast & Vanes found Drive to: Light clearing required Km. 0.0 Erigolia towards Weethalle 10.0 L.H. turn 14.2 L.H. turn near silo 16.9 Gate. Follow fence on right around ploughed paddock 19.0 R.H. turn 19.15 Gate 19.55 R.H. turn up track, follow best course up ridge to Trig 20.5 Trig 
Beacon Diagram Not to Scale	This section to be completed by officer constructing pillar. Original station mark found/not found. Description of mark: Original beacon found/not found. Description of beacon: Height Top of Vanes to Top Mark:m. Height of mark:m. above/below rock/concm. below G.L. Diameter of Vanes:m. Height of Cairn:m. Original Beacon has/has not been destroyed by me.
Date	Record of Station