

CENTRAL MAPPING AUTHORITY

GEODETIC SURVEY OF N.S.W. GEODETIC STATION RECONNAISSANCE and MAINTENANCE REPORT

Description:

- Cleared by lanes bearing  $140^{\circ}M$  —  $23^{\circ}M$   
*Note: Cross out word or words which do not apply*  
 ..... from Trig. Mast
- Mast & Vanes have been painted white & black respectively.  
 The station/pillar was unpiled/~~not unpiled~~/~~constructed on~~..... $19^{\circ}$ ....., dimensions now being:  
 Description of mark: **Brass Plug**..... should be explicit, e.g., S/Steel Pillar Plate, Steel plug, Brass plug, Bolt, G.I. Pipe
- Height of mark..... $0.04$ .....m. above ~~below~~ rock/concrete; Mark is.....m. above below G.L.  
 Height of Top Vanes to Top Mark/Pillar plate.....m. Diameter of Vanes (vertical)..... $0.92$   
 Height of Cairn.....m. Diameter of Cairn.....m. Name Plate found/not found/placed.  
 Length of Mast.....m. (approximate if not unpiled)
- A..... set in conc/rock has been placed/found, bearing..... $^{\circ}M$  from Mast/Plug/Pillar
- A..... set in conc/rock has been placed/found, bearing..... $^{\circ}M$  from Mast/Plug/Pillar
- A..... set in conc/rock has been placed/found, bearing..... $^{\circ}M$  from Mast/Plug/Pillar
- A..... set in conc/rock has been placed/found, bearing..... $^{\circ}M$  from Mast/Plug/Pillar
- Action required: **Requires clearing by lanes bearing  $243^{\circ}M$ ,  $280^{\circ}-290^{\circ}M$ ,  $305^{\circ}M$  —  $335^{\circ}M$ . Possibly 2 days clearing needed**


STANDPOINT:

Mark	Direction	Horiz. Distance	Height Difference	Mark	Direction	Horiz. Distance	Height Difference
			above standpt.				above standpt.
			below standpt.				below standpt.
			above standpt.				above standpt.
			below standpt.				below standpt.
Prepared by: **A. Patterson** Checked: **A. Patterson**

Noted on: U.T.M. Card

8: 2753-1

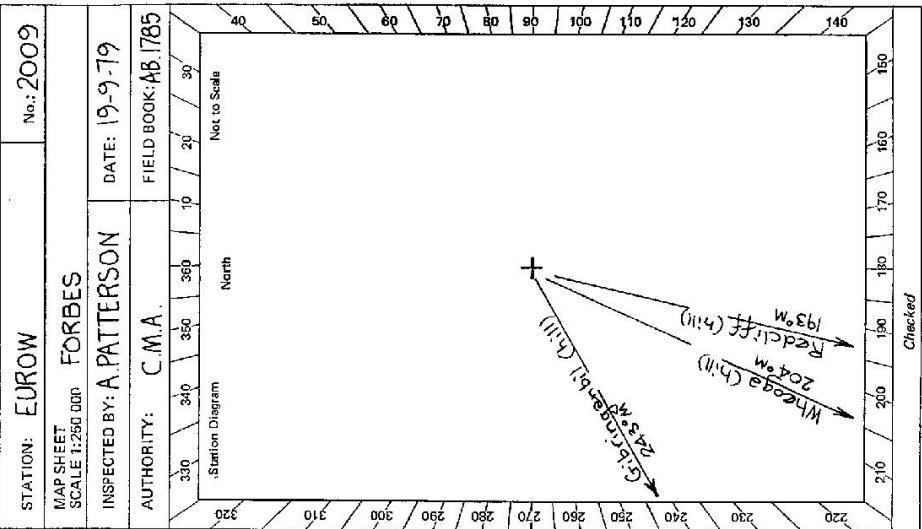


STATION: **EUROW** No.: **2009**

MAP SHEET SCALE 1:250 000 **FORBES**

INSPECTED BY: **A. PATTERSON** DATE: **19-9-79**

AUTHORITY: **C.M.A.** FIELD BOOK: **AB. 1785**

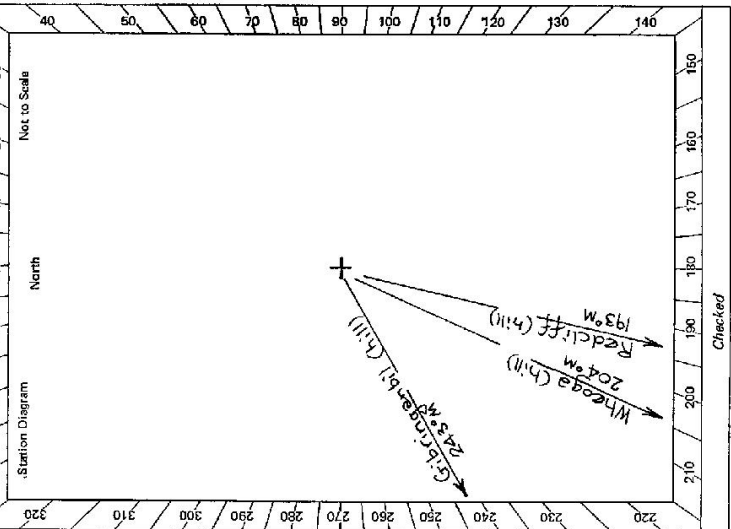

Checked




CENTRAL MAPPING AUTHORITY

GEODETIC SURVEY OF N.S.W.

GEODETIC STATION RECONNAISSANCE and MAINTENANCE REPORT

STATION: **EUROW GS** No.: **2009**

MAP SHEET  
SCALE 1:250,000  
INSPECTED BY: **A. SWERSEN**  
**G. L. FORD**  
DATE: **29/9/89**  
AUTHORITY: **L. I. C.**  
FIELD BOOK: **C60Z**

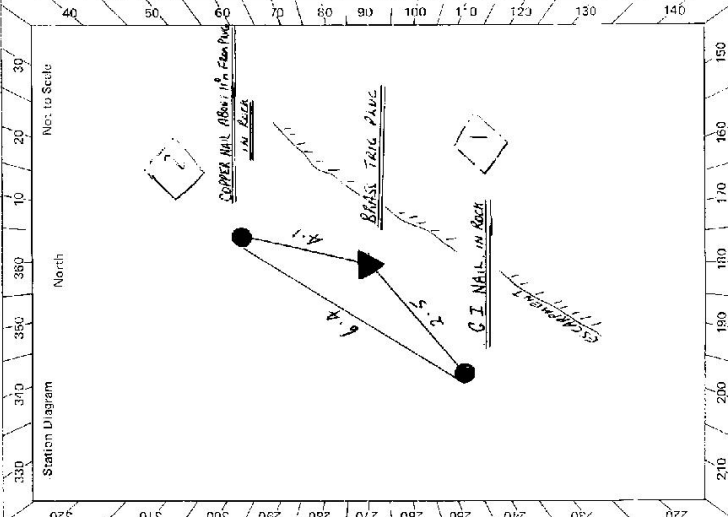

Description: Note: Cross out word or words which do not apply


1. Cleared by lanes bearing  $68^\circ 26'$ ,  $306^\circ 33'$ ,  $358^\circ 24'$  from Trig. Mast
2. Mast & Vanes have been painted white & black respectively.
3. The station/pillar was unpiled/not unpiled/constructed on  $19$  m, dimensions now being:   
 Description of mark: **BRASS PLUG** should be explicit, e.g. S/Steel Pillar-Plate, Steel-plug, Brass plug, Belt, G.I. Pipe  
 (Also check on height of vanes)  
 Height of mark:  $0.04$  m, above rock/concrete; Mark is  $0.04$  m, above G.L.  
 Height of Top Vanes to Top Mark: **Pillar-plate**  $3.0$  m. Diameter of Vanes (vertical)  $0.9$  m.  
 Height of Cairn:  $3.1$  m. Diameter of Cairn:  $3.1$  m. Name Plate found/not found/placed.  
 Length of Mast  $3.1$  m. (approximate if not unpiled) Note: Mast held up with guy wires.
4. A. **BRASS PLUG** set in conc/rock has been placed/removed, bearing  $160^\circ 17'$  from Mast/Pillar/Pillar
5. A. **COPPER MAIL** set in conc/rock has been placed/removed, bearing  $281^\circ 37'$  from Mast/Pillar/Pillar
6. A. **G.I. NAIL** set in conc/rock has been placed/removed, bearing  $284^\circ 38'$  from Mast/Pillar/Pillar
7. A. set in conc/rock has been placed/removed, bearing  $292^\circ 24'$  from Mast/Pillar/Pillar
8. Action required: **TRIG PLUG**  $72$  **2** **STCS** STANDPOINT: **G.I. NAIL**

Mark	Direction	Horiz. Distance	Height Difference	Mark	Direction	Horiz. Distance	Height Difference
<b>MANGAR (P)</b>	$0^\circ 00'$		above standpt.	<b>MANGAR (P)</b>	$0^\circ 00'$		above standpt.
<b>G.I. Nail</b>	$160^\circ 17'$	$2.492$	above standpt.	<b>WOLABLER PLUG</b>	$284^\circ 38'$	$34$	above standpt.
<b>Cv. Nail</b>	$281^\circ 37'$	$16.404$	above standpt.	<b>Cv. Nail</b>	$292^\circ 24'$	$03$	above standpt.
<b>WOLABLER Plug</b>	$284^\circ 38'$	$20$	above standpt.	<b>Trig Plug</b>	$310^\circ 16'$	$53$	above standpt.
			below standpt.				below standpt.
			below standpt.				below standpt.
			below standpt.				below standpt.

Prepared by: **A. Swensen** d. **29/10/89**

Checked: **Noted on U.T.M. Card**

GS 24
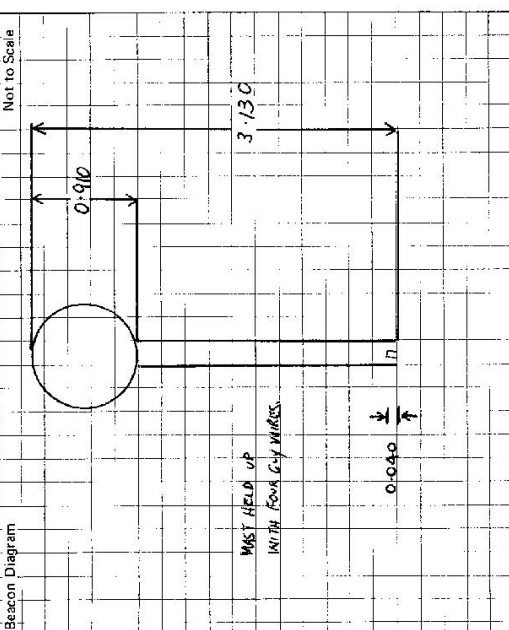
<p>STATION <b>EUROW GS TS 2009</b></p> <p>Owner's Name: <b>T.R. 37409</b></p> <p>Address: .....</p> <p>Phone: .....</p> <p>Current Occupant: .....</p> <p>Address: .....</p> <p>Phone: .....</p> <p>ACCESS <b>29-8-1987</b></p> <p>Access Report of...../1977 was found suitable/unavailable.</p>	<p>Not to Scale</p>  <p>Beacon Diagram</p> <p>This section to be completed by officer constructing pillar.</p> <p>Original station mark found/not found.</p> <p>Description of mark: .....</p> <p>Original beacon found/not found.</p> <p>Description of beacon: .....</p> <p>Height Top of Vanes to Top Mark.....m.</p> <p>Height of mark.....m. above rock/cone.....m. below G.L.</p> <p>Diameter of Vanes.....m. Height of Cairn.....m.</p> <p>Original Beacon has/has not been destroyed by me.</p>
	<p>Date</p> <p>Record of Station</p>