

GEODETTIC SURVEY OF N.S.W.

CENTRAL MAPPING AUTHORITY


GEODETTIC STATION RECONNAISSANCE and MAINTENANCE REPORT

STATION: *EXETER TS* No.: *2018*

MAP SHEET SCALE 1:250 000 *CANBERRA*

INSPECTED BY: *S. GAYNOCK* DATE: *8-3-81*

AUTHORITY: *CMA* FIELD BOOK:

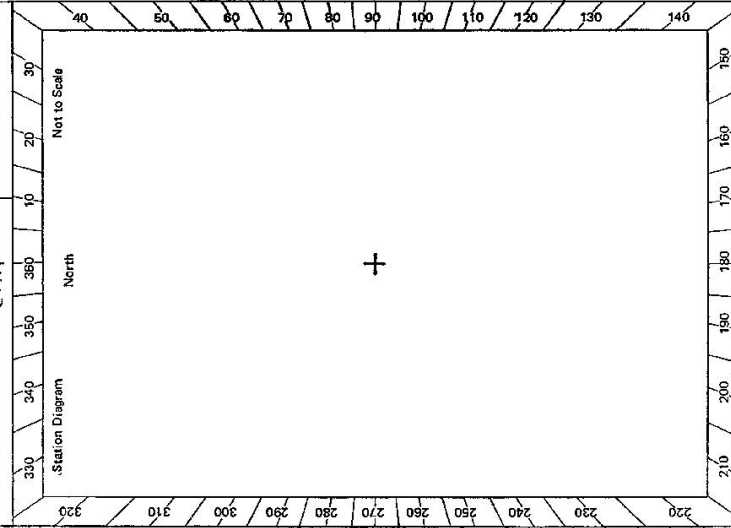

- Description:
- ~~Cleared by...~~ *Note: Cross out word or words which do not apply*
 - ~~Mark is...~~ *Mark is...*
 - The station/pillar was unpiled/not unpiled/constructed on *19*, dimensions now being: Description of mark *should be explicit, e.g., S/Steel Pillar Plate, Steel plug, Brass plug, Bolt, G.I. Pipe*
 - Height of mark *above* rock/concrete; Mark is *above* *m.* *below* G.L.
 - Height of Top Vanes to Top Mark/Pillar plate *m.* Diameter of Vanes (vertical) *m.*
 - Height of Cairn *m.* Diameter of Cairn *m.* Name Plate found/not found/placed.
 - Length of Mast *m.* (approximate if not unpiled)
 - A *set in conc/rock has been placed/found, bearing... M from Mast/Plug/Pillar*
 - A *set in conc/rock has been placed/found, bearing... M from Mast/Plug/Pillar*
 - A *set in conc/rock has been placed/found, bearing... M from Mast/Plug/Pillar*
 - A *set in conc/rock has been placed/found, bearing... M from Mast/Plug/Pillar*
 - Action required: *Trig only, consists of a few rocks holding a 2m high burnt pole (as above)*

STANDPOINT:			
Mark	Direction	Horiz. Distance	Height Difference
			above standpt.
			below standpt.
			above standpt.
			below standpt.
Prepared by: *S. Gaycock* 15/8/81 Checked: *S. Gaycock*

Noted on U.T.M. Card

Checked

Si 2733-1

GS 24

en 2733-2 D. West, Government Printer

Beacon Diagram	Not to Scale	STATION <i>EXETER TS 2018</i>
		Owner's Name: <i>OWEN SIMONS</i>
		Current Occupant: <i>OWEN SIMONS</i>
		Address: <i>"EXETER FARM"</i>
		Phone: <i>048 46 1169</i>
		<u>ACCESS</u>
		Access Report of <i>29/1/1981</i> was found suitable/unsuitable.
0.30	Bradford PD	13.46 Gate. Follow front track straight aheads increasing 160'M
0.44	Straight Ahead / Bolemans Bay on left)	14.10 Dam wall 70m away on right
0.64	Turn right follow MERVIN RD.	14.57 Turn right off track onto front track just after place on gum trees on left
0.97	Turn left follow MERVIN RD.	14.70 Small Creek Bed.
2.65	Straight Ahead (Captains Field Rd on right)	14.75 Big Dam 100m away on right
3.90	Turn right Sign "Majors Creek 13"	15.03 Gate. Turn left towards gate (Did joints 30m away on right)
10.20	Mobile of 3 bridges over Jamboomburne Crk	15.09 Gate Vane right before old tree and head on a 220-230'M direction towards top of hill
10.70	Turn right across grid onto track (houses and sheds on right & left)	15.50 TRIS
11.54	Gate	
11.84	Straight ahead (right fork goes to Durham Hill)	
12.02	Grid	
12.46	Grid	
3.25	Grid	
13.42	Straight ahead	
15.70	Turn left just after brick houses on left	
15.80	Fence corner of backyard of house head 185'M towards gate	
This section to be completed by officer constructing pillar.		Record of Station
Original station mark found/not found.		Date
Description of mark:		
Original beacon found/not found.		
Description of beacon:		
Height Top of Vane to Top Mark:m.		
Height of mark:m. above G.L. below		
Diameter of Vane:m. Height of Cairn:m.		
Original Beacon has/has not been destroyed by me.		