

CENTRAL MAPPING AUTHORITY
Department of Lands

Trigonometrical Survey of N.S.W.

RECONNAISSANCE and MAINTENANCE REPORT

This Trig. Station has been:-

Note: Cross out word or words which do not apply

1. Completely cleared to permit 360° vision to surrounding Trigs.
2. Cleared by lanes bearing 321.3.8.304. ✓ from Trig. Mast
3. Trig. Mast & Vanes have been painted white & black respectively. ✓
4. The Trig. was unpiled/~~restored~~, dimensions now being:
 - Description of mark: ~~Brass plug, Brass plug, Bolt, G.I. Pipe~~ should be explicit, e.g. Steel plug, Brass plug, Bolt, G.I. Pipe
 - Height of mark: 0.0.0.0 m above rock/concrete
 - Height of Top Vanes to Top Mark: 2.3.4.5 m, Diameter of Vanes (vertical) : 7.4.9 m.
 - Height of Cairn: 1.2.0.0 m, Diameter of Cairn: 2.2.2.2 m.
 - Length of Mast: 2.3.4.5 m. (approximate if not unpiled)
5. ~~Cairn~~ Mast set in conc/rock has been placed. 3.2.2.8 m. bearing 49. ✓ from Trig. Mast
6. ~~A.G.I. Mast~~ set in conc/soil has been placed. 3.4.4.5 m. bearing 152. ✓ from Trig. Mast
7. A. set in conc/soil has been placed. m. bearing. m. from Trig. Mast
8. A. set in conc/rock has been placed. m. bearing. m. from Trig. Mast
9. Connection ~~Cairn Mast to G.I. Mast~~ : 5.7.4.4 m. bearing 199. ✓ m
10. Connection to : m. bearing. m
11. Connection to : m. bearing. m
12. Connection to : m. bearing. m
13. Diff. Ht. ~~Set in concrete~~ is : 6.0.4. m. below ~~Station Point~~
14. Diff. Ht. ~~Set in concrete~~ is : 5.1.0. m. below ~~Station Point~~
15. Diff. Ht. is : m. above
16. Diff. Ht. is : m. below


Prepared by: *[Signature]*

Checked: *[Signature]*

Noted on U.T.M. Card

STATION FAULKLAND C.S. TS 2036

Co: ~~GLAUCOSTER~~ PH: FAULKLAND
Map Sheet: ~~GLAUCOSTER~~ No: 370
Inspected by: L.R. HOLLIS Date: 20th Nov '77
Authority: C.M.H. Field Book: 01651

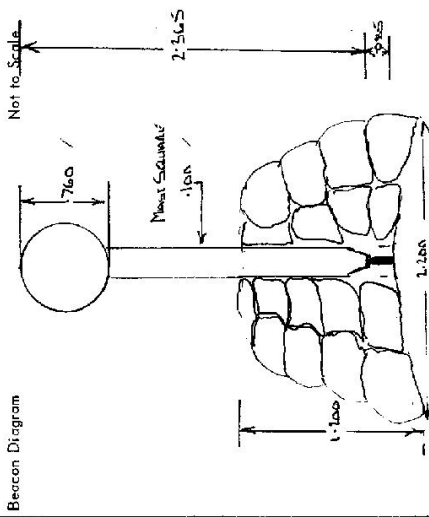

Date	Record of Station

Checked

STATION FRUWLAND IS-2036

Current Occupant.....

Address.....

Owners Name.....


Address.....

Access 30th Nov 1977
 WAS BEAT SENT ALUMINUM —

Not to Scale

Station Diagram

North

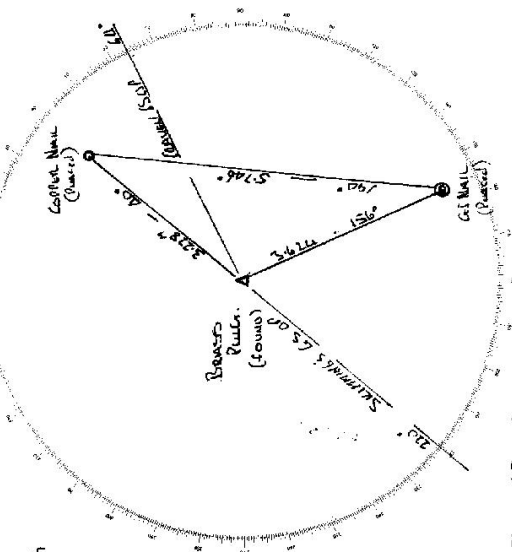

List of Observed Directions:-

Standpoint: BEARS Pt. (round)		Standpoint: COLPIT MALL	
Station	CS Direction	Station	Direction
SALMONS Pt. (round)	182.41	SALMONS Pt. (round)	0.00
COLPIT MALL	204.47	BEARS Pt. (round)	01.41
GI MALL	204.47	COLPIT MALL	284.47
		GI MALL	327.27
Station	Direction	Station	Direction

GEODETTIC SURVEY OF N.S.W.

CENTRAL MAPPING AUTHORITY


GEODETTIC STATION RECONNAISSANCE and MAINTENANCE REPORT

STATION: *FAUKLAND* No.: *2036*

MAP SHEET SCALE 1:250 000 *NEWCASTLE*

INSPECTED BY: *G. DICKSON* DATE: *7th July '78*

AUTHORITY: *C. M. A.* FIELD BOOK: *1629*

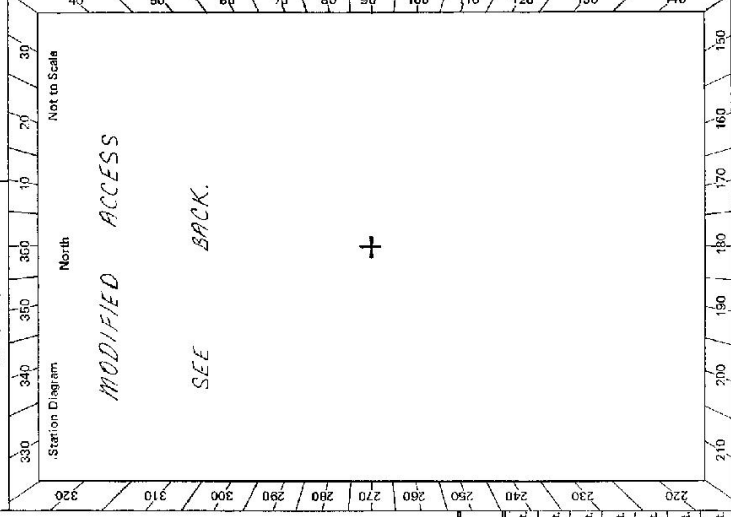

- Description: *Note: Cross out word or words which do not apply*
1. Cleared by James bearing.....: from Trig, Mast
 2. Mast & Vanes have been painted white & black respectively.
 3. The station/pillar was unpiled/not unpiled/constructed on.....: 19....., dimensions now being: Description of mark.....should be explicit, e.g., S/Steel Pillar Plate, Steel plug, Brass plug, Bolt, G.I. Pipe
Height of mark.....m. ^{above} rock/concrete; Mark is.....m. ^{above} G.L.
Height of Top Vanes to Top Mark/Pillar plate.....m. Diameter of Vanes (vertical).....m.
Height of Cairn.....m. Diameter of Cairn.....m. Name Plate found/not found/placed.
Length of Mast.....m. (approximate if not unpiled)
 4. A.....set in conc/rock has been placed/found, bearing.....° M from Mast/Plug/Pillar
 5. A.....set in conc/rock has been placed/found, bearing.....° M from Mast/Plug/Pillar
 6. A.....set in conc/rock has been placed/found, bearing.....° M from Mast/Plug/Pillar
 7. A.....set in conc/rock has been placed/found, bearing.....° M from Mast/Plug/Pillar
 8. Action required:.....

STANDPOINT:						
Mark	Direction	Horiz. Distance	Height Difference	Direction	Horiz. Distance	Height Difference
			above standpt.			above standpt.
			below standpt.			below standpt.
			above standpt.			above standpt.
			below standpt.			below standpt.
Prepared by:..... Checked:.....
Noted on U.T.M. Card

