

CENTRAL MAPPING AUTHORITY  
Department of Lands

Trig: Technical Survey of N.S.W.

RECONNAISSA. and MAINTENANCE REPORT

This Trig. Station has been:-

Note: Cross out word or words which do not apply

1. Completely cleared to permit 360° vision to surrounding Trigs.
2. Cleared by ~~vanes~~ bearing from Trig-Mast
3. Trig-Mast & Vanes have been painted white & black respectively.
4. The Trig. was unpiled/not unpiled, dimensions now being:
  - Description of mark..... should be explicit, e.g. Steel plug, Brass plug, Bolt, G.I. Pipe
  - Height of mark..... m <sup>above</sup> rock/concrete ..... m <sup>below</sup> G.L.
  - Height of Top Vanes to Top Mark..... m. Diameter of Vanes (vertical)..... m.
  - Height of Cairn..... m. Diameter of Cairn..... m.
  - Length of Mast..... m. (approximate if not unpiled)

5. A..... set in conc/rock has been placed..... m. bearing.....°M from Trig. Mast
6. A..... set in conc/soil has been placed..... m. bearing.....°M from Trig. Mast
7. A..... set in conc/soil has been placed..... m. bearing.....°M from Trig. Mast
8. A..... set in conc/rock has been placed..... m. bearing.....°M from Trig. Mast

9. Connection..... to..... m. bearing.....°M
10. Connection..... to..... m. bearing.....°M
11. Connection..... to..... m. bearing.....°M
12. Connection..... to..... m. bearing.....°M
13. Diff. Ht. .... is..... m. <sup>above</sup> below
14. Diff. Ht. .... is..... m. <sup>above</sup> below
15. Diff. Ht. .... is..... m. <sup>above</sup> below
16. Diff. Ht. .... is..... m. <sup>above</sup> below

Prepared by: P. CARR

Checked:

Noted on U.T.M. Card

STATION FEELANCE TS 2044

Co: NORTHUMBERLAND Ph: LOCKYER

Map Sheet: GOSFORD


No: 9131 N

Inspected by: P. CARR

Date: 31/7/76

Authority: C.M.A.

Beacon Diagram Not to Scale

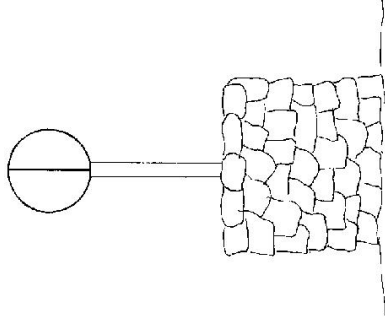

Cairn, Mast & VANES IN Deep-Condition

Date

Record of Station

Checked

Non-Geodetic

