

CENTRAL MAPPING AUTHORITY  
Department of Lands

Trigonometrical Survey of N.S.W.

RECONNAISSANCE and MAINTENANCE REPORT

This Trig. Station has been:-

Note: Cross out word or words which do not apply

1. Completely cleared to permit 360° vision to surrounding Trigs. /
2. Cleared by lances bearing ..... from Trig. Mast
3. Trig. Mast & Vanes have been painted white & black respectively. —
4. The Trig. was unpiled/ not unpiled, dimensions now being: —

Description of mark: DRILL HOLE IN CONC. should be explicit, e.g. Steel plug, Brass plug, Bolt, G.L. Pipe

Height of mark: ..... m <sup>above</sup> / <sub>below</sub> rock/concrete ..... m <sup>above</sup> / <sub>below</sub> G.L.

Height of Top Vanes to Top Mark ..... m. Diameter of Vanes (vertical) ..... m.

Height of Cairn ..... m. Diameter of Cairn ..... m.

Length of Mast ..... m. (approximate if not unpiled)

5. A ..... set in conc/rock has been placed ..... m. bearing ..... ° M from Trig. Mast

6. A ..... set in conc/soil has been placed ..... m.

7. A ..... set in conc/soil has been placed ..... m.

8. A ..... set in conc/rock has been placed ..... m.

9. Connection ..... to ..... m. bearing .....

10. Connection ..... to ..... m. bearing .....

11. Connection ..... to ..... m. bearing .....

12. Connection ..... to ..... m. bearing .....

13. Diff. Ht. .... is ..... m. <sup>above</sup> / <sub>below</sub>

14. Diff. Ht. .... is ..... m. <sup>above</sup> / <sub>below</sub>

15. Diff. Ht. .... is ..... m. <sup>above</sup> / <sub>below</sub>

16. Diff. Ht. .... is ..... m. <sup>above</sup> / <sub>below</sub>

Prepared by: M.L. Morrison Checked: \_\_\_\_\_

Noted on U.T.M. Card

STATION FERNMOUNT ASTRO TS 2047


Co: RALEIGH | Ph: BELMOUND SOUTH

Map Sheet: DURRIGO | No: 9437

Inspected by: M.L. MORRISON | Date: 28<sup>th</sup> JULY 1977

Authority: \_\_\_\_\_ | Field Book: 1580

Beacon Diagram: \_\_\_\_\_ | Not to Scale

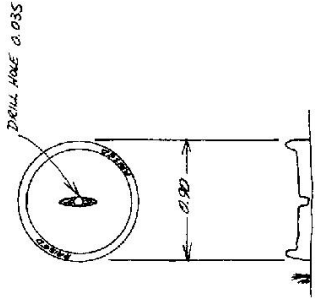

Date

Record of Station

DRILL HOLE IN CEMENT OR CONCRETE PD.  
NO MARK ON BEACON

Checked

