

CENTRAL MAPPING AUTHORITY

GEODETIC SURVEY OF N.S.W.

GEODETIC STATION RECONNAISSANCE and MAINTENANCE REPORT

STATION: **FIEFIELD & S.** No.: **2047**

MAP SHEET SCALE 1:250 000 **NARRDMINE**

INSPECTED BY: **R. COOK** DATE: **SEPT 1978**

AUTHORITY: **C.M.A.** FIELD BOOK:

- Description:
- Cleared by lanes bearing..... from Trig. Mast
Note: Cross out word or words which do not apply
 - Mast & Vanes have been painted white & black respectively.
 - The station/pillar ~~was~~ ^{is} not unpiled/constructed on.....19....., dimensions now being:
Description of mark.....*S.P.D.*.....should be explicit, e.g., S/Steel Pillar Plate, Steel plug, Brass plug, Bolt, G.I. Pipe
Height of mark.....m. ^{above} _{below} rock/concrete; Mark is.....m. ^{above} _{below} G.L.
Height of Top Vanes to Top Mark/Pillar plate.....m. Diameter of Vanes (vertical).....m.
Height of Cairn.....m. Diameter of Cairn.....m. Name Plate found/not found/placed.
Length of Mast.....m. (approximate if not unpiled)
 - A.....set in conc/rock has been placed/found, bearing.....° M from Mast/Plug/Pillar
 - A.....set in conc/rock has been placed/found, bearing.....° M from Mast/Plug/Pillar
 - A.....set in conc/rock has been placed/found, bearing.....° M from Mast/Plug/Pillar
 - A.....set in conc/rock has been placed/found, bearing.....° M from Mast/Plug/Pillar


8. Action required: **SARV STANDARDS ONLY. EXISTING CLEARING NEEDED. SUITABLE FOR FILLER**
IT CLEARED. NAME ON THE STANDPOINT:

Mark	Direction	Horiz. Distance	Height Difference	Mark	Direction	Horiz. Distance	Height Difference
			<small>above below</small>				<small>above below</small>
			<small>above below</small>				<small>above below</small>
Prepared by: **R. COOK**

Checked:

St 2738-1

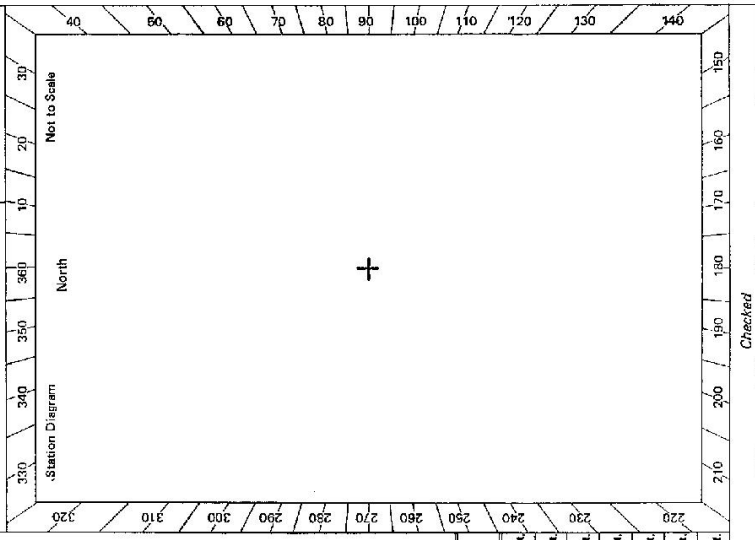

Checked

St. 2733-2 D. West, Government Printer

STATION **FIEFIELD** **G. S. TS. 2049**

Beacon Diagram	Not to Scale

Owner's Name:
 Address:
 Phone:
 Current Occupant:
 Address:
 Phone:

ACCESS

Access Report of **Sept 1978** / 19..... was found suitable/unsuitable.

20 minute walk to Trig. Access is found on the Field
1:50,000 Sheet.

This section to be completed by officer constructing pillar.

Original station mark found/not found.

Description of mark:

Original beacon found/not found.

Description of beacon:

Height Top of Varies to Top Mark.....m.

Height of mark.....m. above G.L.
 rock/conc.....m. below

Diameter of Variesm. Height of Cairnm.

Original Beacon has/has not been destroyed by me.

Date

Sept 1978

Record of Station

STATION VARIES in connection with Field Completion