

CENTRAL MAPPING AUTHORITY
Department of Lands

Trig Station and MAINTENANCE REPORT
RECONNAISSANCE

This Trig. Station has been:

Note: Cross out word or words which do not apply

1. Completely cleared to permit 360° vision to surrounding Trigs.
2. Cleared by lanes bearing from Trig-Mast
3. Trig-Mast & Vanes have been painted white & black respectively.
4. The Trig. was unpiled/not unpiled, dimensions now being:

Description of mark..... should be explicit, e.g. Steel plug, Brass plug, Bolt, G.I. Pipe

Height of mark..... m ^{above} rock/concrete m ^{below} G.L.

Height of Top Vanes to Top Mark..... m. Diameter of Vanes (vertical)..... m.

Height of Cairn..... m. Diameter of Cairn..... m.


Length of Mast..... m. (approximate if not unpiled)
5. A..... set in conc/rock has been placed..... m. bearing.....°M from Trig. Mast
6. A..... set in conc/soil has been placed..... m. bearing.....°M from Trig. Mast
7. A..... set in conc/soil has been placed..... m. bearing.....°M from Trig. Mast
8. A..... set in conc/rock has been placed..... m. bearing.....°M from Trig. Mast
9. Connection..... to..... m. bearing.....°M
10. Connection..... to..... m. bearing.....°M
11. Connection..... to..... m. bearing.....°M
12. Connection..... to..... m. bearing.....°M
13. Diff. Ht. is..... m. ^{above} below
14. Diff. Ht. is..... m. ^{above} below
15. Diff. Ht. is..... m. ^{above} below
16. Diff. Ht. is..... m. ^{above} below

Prepared by: P. CARR Checked: _____ Noted on U.T.M. Card

STATION FINIS T.S. 2053
Co: NORTHUMBERLAND Ph: KOOREE

Map Sheet: GOSFORD No: 9131 S
Inspected by: P. CARR Date: 11/8/76
Authority: C.M.A. Field Book:

Beacon Diagram Not to Scale

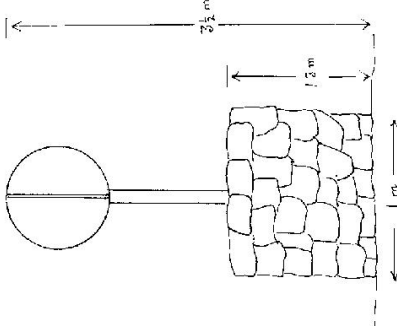

CAIRN, MAST and VANES in Good Condition

Date	Record of Station

Checked

Non-geodetic

