

CENTRAL MAPPING AUTHORITY

GEODETIC SURVEY OF N.S.W.

GEODETIC STATION RECONNAISSANCE and MAINTENANCE REPORT

Description:

- 1. Cleared by lances bearing ~~50° 30' N~~ ^{White} ~~50° 30' N~~ from Trig. Mast
- 2. Mast & Vanes have been painted white & ~~black~~ ^{black} respectively. **MWS-DB**
- 3. The station ~~after~~ was unpilled/~~not unpilled~~/~~constructed~~ on ~~concrete~~ ^{concrete} 19. dimensions now being:
 Description of mark ~~is in concs.~~ should be explicit, e.g., S/Steel Pillar Plate, Steel plug, Brass plug, Bolt, G.I. Pipe
 Height of mark ~~is in concs.~~ ^{above} rock/concrete; Mark is ~~is in concs.~~ ^{above} ~~below~~ G.L.
 Height of Top Vanes to Top Mark/~~Pillar plate~~ ^{4.850} ~~4.850~~ m. Diameter of Vanes (vertical) ~~0.125~~ ^{0.125} m.
 Height of Cairn ~~is in concs.~~ ^{above} ~~below~~ m. Diameter of Cairn ~~is in concs.~~ ^{above} ~~below~~ m. Name Plate found/not found/~~placed~~
 Length of Mast ~~is in concs.~~ ^{above} ~~below~~ m. (approximate if not unpilled)
- 4. A ~~is in concs.~~ ^{above} ~~below~~ set in conc/rock has been placed/found, bearing ~~is in concs.~~ ^{above} ~~below~~ ° M from Mast/Plug/Pillar
- 5. A ~~is in concs.~~ ^{above} ~~below~~ set in conc/rock has been placed/found, bearing ~~is in concs.~~ ^{above} ~~below~~ ° M from Mast/Plug/Pillar
- 6. A ~~is in concs.~~ ^{above} ~~below~~ set in conc/rock has been placed/found, bearing ~~is in concs.~~ ^{above} ~~below~~ ° M from Mast/Plug/Pillar
- 7. A ~~is in concs.~~ ^{above} ~~below~~ set in conc/rock has been placed/found, bearing ~~is in concs.~~ ^{above} ~~below~~ ° M from Mast/Plug/Pillar
- 8. Action required: ~~is in concs.~~ ^{above} ~~below~~ **Moss Vale** ~~is in concs.~~ ^{above} ~~below~~ **Std. Topo**

STANDPOINT:

Mark	Direction	Horiz. Distance	Height Difference	Mark	Direction	Horiz. Distance	Height Difference
			above standpt. below				above standpt. below
			above standpt. below				above standpt. below
Prepared by: *A. Svartesen* 35/1 Checked: *A. Svartesen*

Noted on U.T.M. Grid

STATION: **FITZROY** No: **2065**

MAP SHEET SCALE 1:250 000 **Wollongong**

INSPECTED BY: **A. Svartesen** DATE: **17-1-79**

AUTHORITY: **CMA** FIELD BOOK: **17233**

Station Diagram

North **327°M**

Gibraltar Tower **14-142**
149-220
275-354

Clear **6-10°M** (Close hill)

220-260 Top of this hill blocks horizon

Extensive views in cleared area.

No ecc marks found (in high grass)

+

Good Δ site. May be more suitable than BOREAWANG

Not to Scale

Checked

S:2733-2 D. West, Government Printer


STATION **FITZROY TS 2065**

Owner's Name:
 Address:
 Phone:
 Current Occupant:
 Address:
 Phone:

ACCESS

Access Report of 17.1.19 was found suitable/unsuitable.
 2 wd
 4 wd in wet

- km
- 0.0 RANGERS H.Q at FITZROY FALLS head towards MOSS VALE
- 1.1 Take BOWRAL road to R
- 4.2 Take BRESNAHANS road on R
- 5.3 OWNERS house on R
- 5.8 Turn R at T intersection
- 6.85 Turn R through wire gate
- 7.1 Old gate
- 7.3 FITZROY ▲

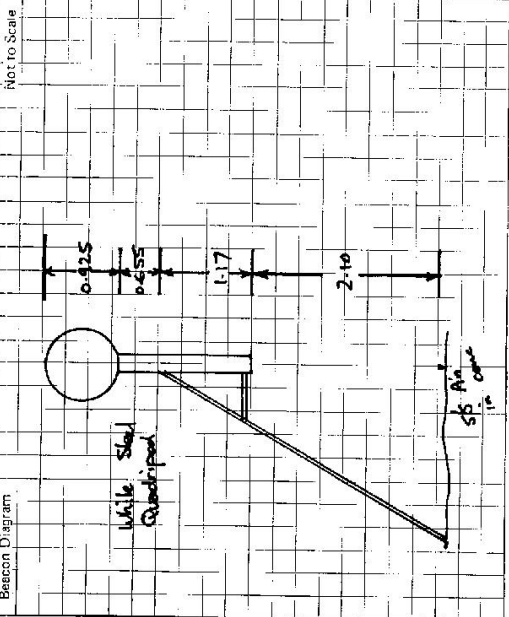

This section to be completed by officer constructing pillar.

Original station mark found/not found.

Description of mark:

Original beacon found/not found.

Description of beacon:

Height Top of Vanes to Top Markm.

Height of markm. above rock/concm. below G.L.

Diameter of Vanesm. Height of Cairnm.

Original Beacon has/has not been destroyed by me.

Date

Reserve of Station