

GEODETIC SURVEY OF N.S.W.

CENTRAL MAPPING AUTHORITY


GEODETIC STATION RECONNAISSANCE and MAINTENANCE REPORT

STATION: FLYNN No.: 2080

MAP SHEET SCALE 1:250 000 CANBERRA

INSPECTED BY: G. C. HANNA DATE: 23/4/79


AUTHORITY: C. M. A. FIELD BOOK:

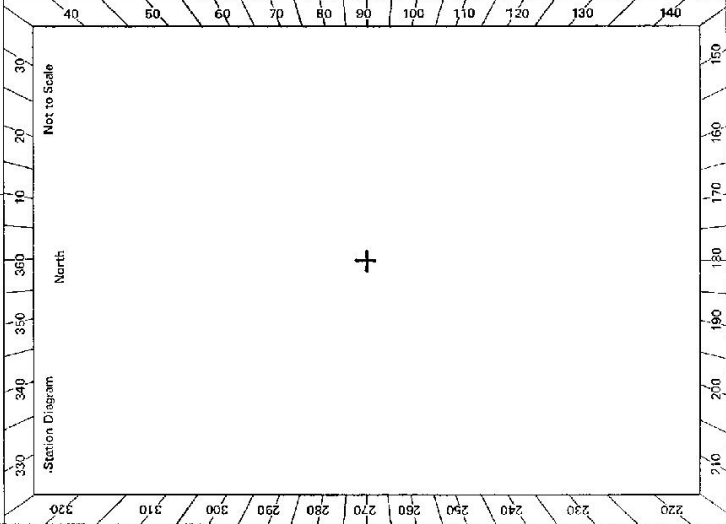

- Description:
- Note: Cross out word or words which do not apply
1. Cleared by lances bearing..... from Trig. Mast
 2. Mast & Vanes have been painted white & black respectively.
 3. The station/pillar was unpiled/not unpiled/constructed on..... 19....., dimensions now being:
Description of mark..... should be explicit, e.g., S/Steel Pillar Plate, Steel plug, Brass plug, Bolt, G.I. Pipe
Height of mark..... m. above below rock/concrete; Mark is..... m. above below G.L.
 - Height of Top Vanes to Top Mark/Pillar plate..... m. Diameter of Vanes (vertical)..... m.
 - Height of Cairn..... m. Diameter of Cairn..... m. Name Plate found/not found/placed.
 - Length of Mast..... m. (approximate if not supplied)
 4. A..... set in conc/rock has been placed/found, bearing.....°M from Mast/Plug/Pillar
 5. A..... set in conc/rock has been placed/found, bearing.....°M from Mast/Plug/Pillar
 6. A..... set in conc/rock has been placed/found, bearing.....°M from Mast/Plug/Pillar
 7. A..... set in conc/rock has been placed/found, bearing.....°M from Mast/Plug/Pillar
 8. Action required.....

STANDPOINT:			
Mark	Direction	Horiz. Distance	Height Difference
			above standpt.
			below standpt.
			above standpt.
			below standpt.
Prepared by: *G. Hanna* 7/5/79 Checked: *G. Hanna* Noted on U.T.M. Card
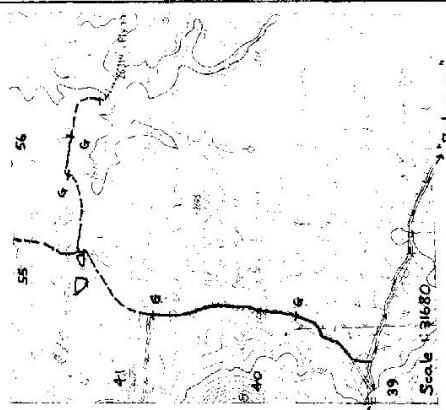
<p>S. 2733-2 D. West, Government Printer</p> <p>Beacon Diagram</p> <div style="border: 1px solid black; width: 100%; height: 150px; text-align: center; line-height: 150px;">Not to Scale</div>	<p style="text-align: center;">STATION FLYNN TS 2080</p> <p>Owner's Name:</p> <p>Address:</p> <p>Phone:</p> <p style="text-align: center;">ACCESS</p> <p>Access Report of <u>23/4/1979</u> was found suitable/unsuitable.</p> <p>Cairn only found 5 minute walk Obstruction from hills to East No clearing reqd.</p> <p>Possible access from East.</p>	
<p>This section to be completed by officer constructing pillar.</p> <p>Original station mark found/not found.</p> <p>Description of mark:</p> <p>Original beacon found/not found.</p> <p>Description of beacon:</p> <p>Height Top of Vanes to Top Mark.m.</p> <p>Height of mark.m. above below rock/conc above below G.L.</p> <p>Diameter of Vanesm. Height of Cairnm.</p> <p>Original Beacon has/has not been destroyed by mts.</p>		<p>Date</p> <p>Record of Station</p>
<p style="text-align: center;">For further information see Manar 8827-III-N</p>		