

CENTRAL MAPPING AUTHORITY
Department of Lands

Trig
RECONNAISSANCE REPORT

STATION FOOD T.S. 2081
Ph: SPENZER

This Trig. Station has been:-

Note: Cross out word or words which do not apply


Co: NORTHUMBERLAND
Map Sheet: GOSFELD
Inspected by: K. J. HADLOW
Authority: C.M.A.
Field Book:
Not to Scale

1. Completely ~~cleared~~ to permit 360° vision to surrounding Trigs.
2. Cleared by lances bearing from Trig. Mast
3. Trig. Mast & Vanes have been painted white & black respectively.
4. The Trig. was ~~unpiled~~/not unpiled, dimensions now being:
 - Description of mark: should be explicit, e.g. Steel plug, Brass plug, Bolt, G.I. Pipe
 - Height of mark: m above rock/concrete
 - Height of Top Vanes to Top Mark: m. Diameter of Vanes (vertical) m.
 - Height of Cairn: m. Diameter of Cairn: m.

5. A. set in conc./rock has been placed. m. bearing °M from Trig. Mast
6. A. set in conc./soil has been placed. m. bearing °M from Trig. Mast
7. A. set in conc./soil has been placed. m. bearing °M from Trig. Mast
8. A. set in conc./rock has been placed. m. bearing °M from Trig. Mast
9. Connection to m. bearing °M
10. Connection to m. bearing °M
11. Connection to m. bearing °M
12. Connection to m. bearing °M
13. Diff. Ht. is m. active below
14. Diff. Ht. is m. active below
15. Diff. Ht. is m. active below
16. Diff. Ht. is m. active below

Prepared by: K. J. HADLOW Checked: 29/5/22 Noted on U.T.M. Card

Non-Geodetic

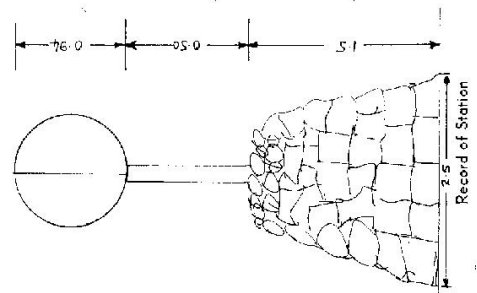

Date	Record of Station

