

CENTRAL MAPPING AUTHORITY

Department of Lands

Trigonometrical Survey of N.S.W.

RECONNAISSANCE and MAINTENANCE REPORT

This Trig. Station has been:-

Note: Cross out word or words which do not apply

1. Completely cleared to permit 360° vision to surrounding Trig.
2. Cleared by lanes bearing TRIG IS SURROUNDED BY TREES. VISIBILITY NIL. from Trig. Mast
3. Trig. Mast & Vanes have been painted white & black respectively.
4. The Trig. was unpiled/not unpiled, dimensions now being:

Description of mark..... should be explicit, e.g. Steel plug, Brass plug, Bolt, G.I. Pipe
 Height of mark..... m ^{above} _{below} rock/concrete m ^{above} _{below} G.L.
 Height of Top Vanes to Top Mark..... m. Diameter of Vanes (vertical)..... m.

Height of Cairn 1.2 m. Diameter of Cairn..... m.
 Length of Mast..... m. (approximate if not unpiled)


5. A..... set in conc/rock has been placed..... m. bearing.....°M from Trig. Mast
6. ~~A.GUPIPE~~..... set in conc/soil has been placed 62.77 m. bearing 161.....°M from Trig. Mast
7. A..... set in conc/soil has been placed..... m. bearing.....°M from Trig. Mast
8. A..... set in conc/rock has been placed..... m. bearing.....°M from Trig. Mast

9. Connection..... to..... m. bearing.....°M
10. Connection..... to..... m. bearing.....°M
11. Connection..... to..... m. bearing.....°M
12. Connection..... to..... m. bearing.....°M

13. Diff. Ht. GUPIPE is 7.9 m. ^{above} _{below} TOP OF MAST FOREST HILL
14. Diff. Ht. is..... m. ^{above} _{below} TRIG NOT ON NSW/VIC BORDER.
15. Diff. Ht. is..... m. ^{above} _{below}
16. Diff. Ht. is..... m. ^{above} _{below}

Prepared by: R. LANDER Checked: Alan Woodcock Noted on U.T.M. Card

STATION FOREST HILL ECCENTRIC
 Co: No: 6524-S
 Inspected by: A WOODCOCK, W. MILLER
 Date: 12-2-77
 Authority: CENTRAL MAPPING
 Field Book: 1531
 Beacon Diagram Not to Scale

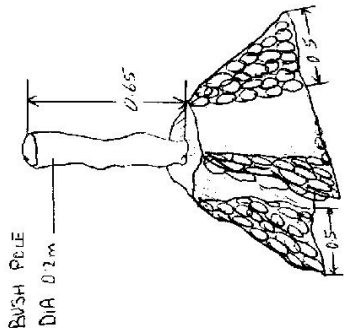

HEIGHT OF CAIRN 1.2 m
 DIA OF TOP OF CAIRN 1.1 m
 DIA. OF BOTTOM OF CAIRN 1.8 m
 Date 12-2-77
 Record of Station
 THIS TRIG IS COMPLETELY ENCLOSED BY LARGE TREES THE BUSH POLE IS ROTTEN.

Checked

