

22-B2

Department of Lands      Survey of N.S.W.      RECONNAISSANCE and MAINTENANCE REPORT

STATION IS FORT DENISON 2091  
 CO: CUMBERLAND      Pt: CITY OF SYDNEY  
 Map Sheet: SYDNEY      No: 1845  
 Inspected by: J.L. Fletcher      Date: 29.6.79  
 Authority Dept. of Lands      Field Book: \_\_\_\_\_  
 Beacon Diagram      Not to Scale

This Trig. Station has been:-  
 Note: Cross out word or words which do not apply

- 1. Completely cleared to permit 360° vision to surrounding Trigs.
- 2. Cleared by lanes bearing..... from Trig. Mast
- 3. Trig. Mast & Vanes have been painted white & black respectively.
- 4. The Trig. was unpiled/not unpiled, dimensions now being:

Description of mark: ~~conc. base~~ ~~stone~~ ~~top light~~ <sup>stone</sup>      should be explicit, e.g. Steel plug, Brass plug, Bolt, Concrete Pillar

Height of mark.....m <sup>above</sup> <sub>below</sub> rock/concrete .....m      G.L.


Height of Top Vanes to Top Mark/Top pillar plate.....m Diameter of Vanes (vertical).....m.

Height of Cairn.....m. Diameter of Cairn.....m.

Length of Mast.....m. (approximate if not unpiled)

- 5. ~~SSW 2536~~ set in ~~conc~~/rock has been placed/fd ~~5.115~~ m. bearing ~~283~~ °M from Trig. Mast/pillar:
- 6. A.....set in conc/soil has been placed/fd.....m. bearing.....°M from Trig. Mast/pillar
- 7. A.....set in conc/soil has been placed/fd.....m. bearing.....°M from Trig. Mast/pillar
- 8. A.....set in conc/rock has been placed/fd.....m. bearing.....°M from Trig. Mast/pillar
- 9. Connection ~~EM 22536 to PM 151~~; ~~54.385~~ m. bearing ~~248.30~~ °M
- 10. Connection.....to.....m. bearing.....°M
- 11. Connection.....to.....m. bearing.....°M
- 12. Connection.....to.....m. bearing.....°M
- 13. Diff. Ht. .... is.....m. <sup>above</sup> <sub>below</sub>
- 14. Diff. Ht. .... is.....m. <sup>above</sup> <sub>below</sub>
- 15. Diff. Ht. .... is.....m. <sup>above</sup> <sub>below</sub>
- 16. Diff. Ht. .... is.....m. <sup>above</sup> <sub>below</sub>

Prepared by: J.L. Fletcher      Checked: JL

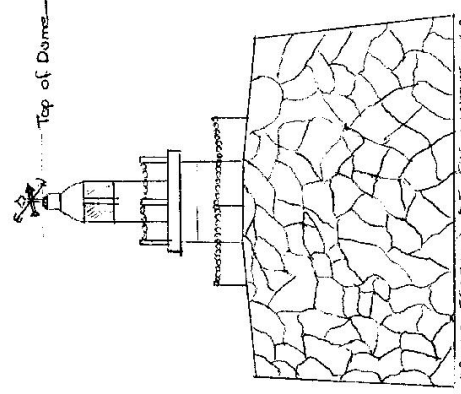

Date	Record of Station

STATION 2091 **O** TS FORT DENISON

Owners Name: MARITIME SERVICES BOARD

Current Occupant: .....




Address: CIRCULAR QUAY, .....

Address: .....

29-6-1979

Access BY BOAT, CONTACT MARITIME SERVICES BOARD

REFERENCE TO PLAN ALEX. 291XL

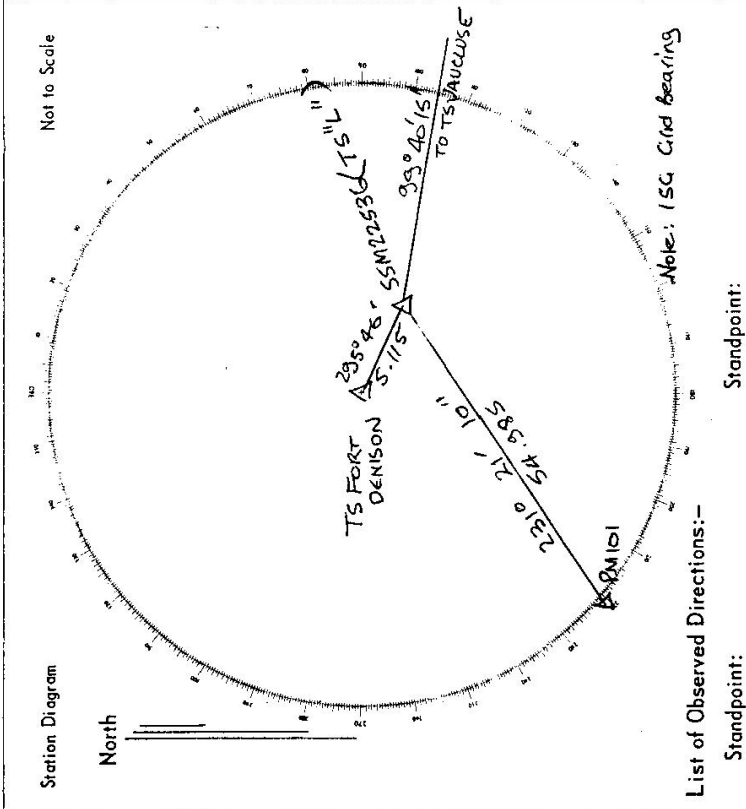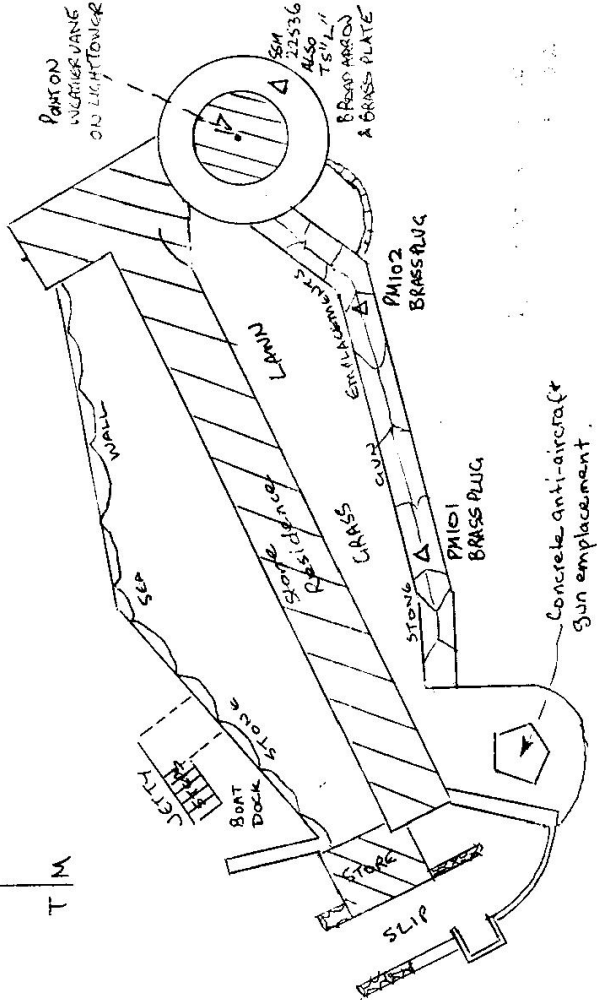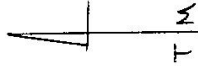

Note: ISC Grid bearing

List of Observed Directions:-

Standpoint:		Standpoint:	
Station	Direction	Station	Direction