

GEODETTIC SURVEY OF N.S.W.

CENTRAL MAPPING AUTHORITY

GEODETTIC STATION RECONNAISSANCE and MAINTENANCE REPORT

STATION: **FOWLER** No.: **2100**

MAP SHEETS **WAGGA WAGGA** SCALE 1:100 000

INSPECTED BY: **J. Southern** DATE: **18th Feb 1989**

AUTHORITY: **CMA** FIELD BOOK: **---**

Description: *Note: Cross out word or words which do not apply*

1. Cleared by lanes bearing ~~327°-40°-59°-78°-160°-110°-178°-196°-232°-245°-315°~~ from Trig. Mast

~~2. Mast & Vanes have been painted white & black respectively.~~

3. The station ~~pillar~~ was unplied/~~not unplied~~/~~constructed~~ on ~~18th Feb~~ **19.82**, dimensions now being:

Description of mark **NO G.L.** should be explicit, e.g., S/Steel Pillar Plate, Steel plug, Brass plug, Bolt, G.I. Pipe

Height of mark ~~---~~ ^{above} ~~below~~ rock/concrete; Mark is ~~---~~ ^{above} ~~below~~ G.L.

Height of Top Vanes to Top Mark/Pillar plate ~~---~~ m. Diameter of Vanes (vertical) ~~---~~ m.

Height of Cairn ~~0.5~~ m. Diameter of Cairn ~~1.0~~ m. ~~Name Plate found/not found/placed.~~

Length of Mast ~~NIL~~ m. (approximate if not unplied)


4. A ~~NIL~~ set in conc/rock has been placed/found, bearing ~~---~~ °M from Mast/Plug/Pillar

5. A ~~---~~ set in conc/rock has been placed/found, bearing ~~---~~ °M from Mast/Plug/Pillar

6. A ~~---~~ set in conc/rock has been placed/found, bearing ~~---~~ °M from Mast/Plug/Pillar

7. A ~~---~~ set in conc/rock has been placed/found, bearing ~~---~~ °M from Mast/Plug/Pillar

8. Action required: ~~---~~

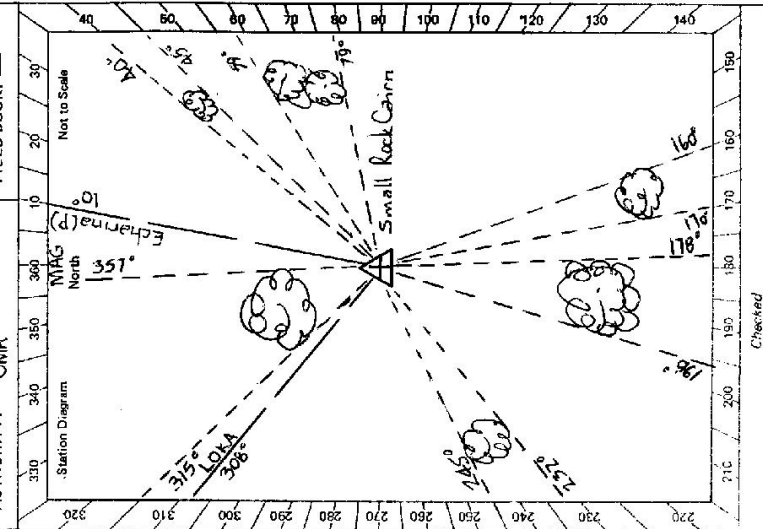

STANDPOINT:				STANDPOINT:			
Mark	Direction	Horiz. Distance	Height Difference	Mark	Direction	Horiz. Distance	Height Difference
			above standpt.				above standpt.
			below standpt.				below standpt.
			above standpt.				above standpt.
			below standpt.				below standpt.
Prepared by: *[Signature]* 18.2.89

Checked: *[Signature]*

Noted on U.T.M. Card

Checked: *[Signature]*

18.2.89

2733-2 D West Government Printer

Beacon Diagram: Not to Scale

STATION **FOWLER IS 2100**

Owner's Name: Bernard Horz
 Address: "Echarina" Echarina Road
Via Mullengandra 2644
 Phone: (060) 704228
 Current Occupant: Outcast
 Address:
 Phone:

Dry Weather ACCESS ONLY

Access Report of 18/7/1989 was found suitable/unusable.

- 0.00 Intersection of Home Highway and Echarina Road. Head along Echarina Road
- 1.00 Culvert over gully.
- 1.61 Grid and gate. Signposted "Here Poll Hereford's Echarina."
- 1.88 Homestead. See owner before proceeding. Follow track.
- 1.96 Turn right and go through gateway.
- 2.06 Gateway.
- 2.36 Ford.
- 2.46 Go through iron gate and follow laneway.
- 3.07 At double gates follow laneway to south.
- 3.95 Go through double white gates.
- 4.00 Go through iron gate (signposted "Kerijong") on LHS. Head east paralleling gully and fence line.
- 4.69 Pass dam on RHS - drive around head of gully.
- 5.08 Cross above contour bank in small gully. Continue to south parallel to fence line.
- 3.50 At double gates go through RHS gate and head south keeping parallel to fence and 100m distant from it.
- 4.05 At head of gully erosion follow faint wheel tracks to south.
- 6.42 Near large gum head 1650M up side of hill (keep 100m right of eroded gully)
- 6.85 At ridge line turn left. 6.95 Follow rocky and rough track
- 7.16 Sharp J H hairpin bend. 7.10 Stop track in saddle - track is latin, easy walk to North.

Date: Record of Station:

This section to be completed by officer constructing pillar.

Original station mark found/not found.

Description of mark:

Original beacon found/not found.

Description of beacon:

Height Top of Vanes to Top Mark m.

Height of mark m. above G.L. below

Diameter of Vanes m. Height of Cairn m.

Original Beacon has/has not been destroyed by me.