

CENTRAL MAPPING AUTHORITY
Department of Lands

Trigonometrical Survey of N.S.W.

RECONNAISSANCE and MAINTENANCE REPORT

STATION FIRESTONE TS 2107

This Trig. Station has been:-

Note: Cross out word or words which do not apply

Co: CAMDEN
Map Sheet:
Inspected by: G.L. BROWN
Authority: D.M.R.
Beacon Diagram
No: 75 2107
Date: 23-1-1975
Field Book:
Net to Scale

1. Completely cleared to permit 360° vision to surrounding Trig.
2. Cleared by lanes bearing 190° (to Trig. Mast) and 230° (to Trig. Mast) from Trig. Mast
3. Trig. Mast & Vanes have been painted white & black respectively.
4. The Trig. was found unspiled, dimensions now being:

Description of mark: 8 x 8 x 8 ft. should be explicit, e.g. Steel plug, Brass plug, Bolt, G.I. Pipe

Height of mark: m above rock/concrete m below G.L.

Height of Top Vanes to Top Mark: m Diameter of Vanes (vertical): 0.188 m.

Height of Cairn: m Diameter of Cairn: m.

Length of Mast (PERS. OR B.): m. (approximate if not spiled)

5. A. set in conc/rock has been placed m. bearing °M from Trig. Mast
6. A. set in conc/soil has been placed m. bearing °M from Trig. Mast
7. A. set in conc/soil has been placed m. bearing °M from Trig. Mast
8. A. set in conc/rock has been placed m. bearing °M from Trig. Mast

9. Connection: 1/1 to Centre of P.M.A. Tower: 13.50 m. bearing 53° 14' true bearing.

10. Connection: to m. bearing °M

11. Connection: to m. bearing °M

12. Connection: to m. bearing °M

13. Diff. Ht. is m. above below

14. Diff. Ht. is m. above below

15. Diff. Ht. is m. above below

16. Diff. Ht. is m. above below

Date

Record of Station

Prepared by: J. McGeary Checked: G. L. BROWN 4/1/75 Noted on U.T.M. Card

Checked

GEODETTIC SURVEY OF N.S.W.

CENTRAL MAPPING AUTHORITY

GEODETTIC STATION RECONNAISSANCE and MAINTENANCE REPORT

Description: *Note: Cross out word or words which do not apply*

1. Cleared by lances bearing..... from Trig. Mast
2. Mast & Vanes have been painted white & black respectively.
3. The station/pillar was unpiled/put up/..... constructed on..... 19....., dimensions now being:
Description of mark..... should be explicit, e.g., S/Steel Pillar Plate, Steel plug, Brass plug, Bolt, G.I. Pipe
- Height of mark..... ^{above} ~~below~~ concrete; Mark is..... ^{above} ~~below~~ G.L.
- Height of Top Vanes to Top Mark/Pillar plate.....m. Diameter of Vanes (vertical).....m.
- Height of Cairn.....m. Diameter of Cairn.....m. Name Plate found/not found/placed.
- Length of Mast.....m. (approximate if not unpiled)
4. A..... ~~set in conc/rock~~ has been ~~placed~~/found, bearing.....°M from Mast/Plug/Pillar
TRIG STATION CONCRETE MARK 03/99
5. A..... ~~set in conc/rock~~ has been placed/found, bearing.....°M from Mast/Plug/Pillar
6. A..... ~~set in conc/rock~~ has been placed/found, bearing.....°M from Mast/Plug/Pillar
7. A..... ~~set in conc/rock~~ has been placed/found, bearing.....°M from Mast/Plug/Pillar
8. Action required:.....

Report

Trig pt eroded. Bronze trig plate set 0.04m above concrete. Lances have been cleaned 16/11/78. All is good, completely cleaned 16/11/78. LARGE BRONZE TOWER TO THE EAST OF TRIG. A lot of clearing required to the south and to the east (only need an offset to the east.)

Prep and by:


Checked:

Noted on U.M. Card

16/11/78

Checked

STATION: *FREESTONE G.S.* No: *2107*
 MAP SHEET SCALE 1:250 000
 INSPECTED BY: *M.L. Thompson* DATE: *21/10/68*
 AUTHORITY: *C.M.A.* FIELD BOOK: *1710*

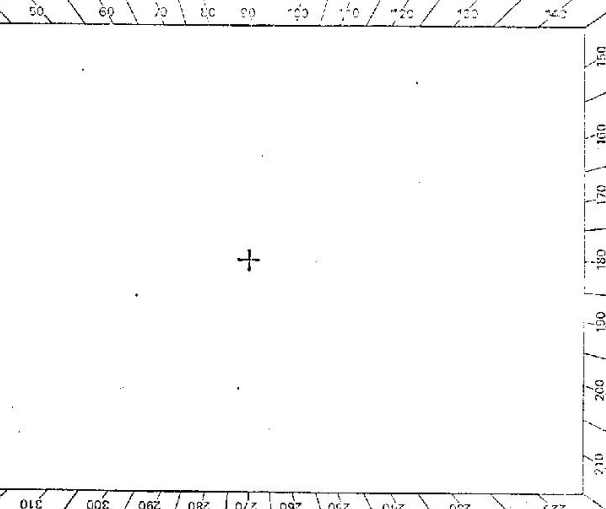

CENTRAL MAPPING AUTHORITY

GEODETIC SURVEY OF N.S.W.

GEODETIC STATION RECONNAISSANCE and MAINTENANCE REPORT

Description:

1. Cleared by lanes bearing..... *Conserved by Dams & Fisheries* from Trig. Mast

2. Mast & Vanes have been painted white & black respectively. *found unpainted*

3. The station/pillar was ~~unplaced~~ *replaced* on *19.8.83*, dimensions now being:

Description of mark..... should be explicit, e.g., S/Steel Pillar Plate, Steel plug, Brass plug, Bolt, G.I. Pipe

Height of mark.....m, ^{above} rock/concrete, _{below} G.L. Mark is.....m, ^{above} G.L., _{below}

Height of Top Vanes to Top Mark/Pillar plate.....m. Diameter of Vanes (vertical).....m.

Height of Cairn.....m. Diameter of Cairn.....m. Name Plate found/not found/placed.

Length of Mast.....m. (approximate if not unpled)

4. A..... *D.M.R. Survey Mark No 23199* in conc/rock has been ~~placed~~ *found*, bearing.....°M from Mast/Plug/Pillar

5. A..... set in conc/rock has been placed/ ~~found~~ *found*, bearing.....°M from Mast/Plug/Pillar

6. A..... set in conc/rock has been placed/ ~~found~~ *found*, bearing.....°M from Mast/Plug/Pillar

7. A..... set in conc/rock has been placed/ ~~found~~ *found*, bearing.....°M from Mast/Plug/Pillar

8. Action required: *TOWER SIGHTED KEY SHIRING ABOUT 50 METRES to EAST*

STANDPOINT:

Mark	Direction	Horiz. Distance	Height Difference	Mark	Direction	Horiz. Distance	Height Difference
			above standpt				above standpt
			below				below
			above standpt				above standpt
			below				below
Prepared by:

Checked:

Noted on U.T.M. Card

S: 2733-1

STATION: *FREESTONE CS.* No.: *2107*

MAP SHEET SCALE 1:250 000 *WILLSONBONGA.*

INSPECTED BY: *P.P. POTTS.* DATE: *24.8.83*

AUTHORITY: *C.M.A.* FIELD BOOK: *1944.*

Station Diagram

Not to Scale

Checked

CENTRAL MAPPING AUTHORITY

GEODETIC SURVEY OF N.S.W.

GEODETIC STATION RECONNAISSANCE and MAINTENANCE REPORT

- Description: *Notes: Cross out word or words which do not apply*
- Cleared by lanes bearing *As per information* from Trig. Mast
 - Mast & Vanes have been painted white & black respectively, X
 - The station/~~marker~~ ^{iron nail} was ~~unplaced~~ ^{unplaced} on *19.24*, dimensions now being: Description of mark *Steel Plate*, should be explicit, e.g., S/Steel Pillar Plate, Steel plug, Brass plug, Bolt, G.I. Pipe
Height of mark *0.12* m. ^{above} ~~below~~ rock/concrete; Mark is *0.12* m. ^{above} ~~below~~ G.L.
Height of Top Vanes to Top Mark/Pillar plate *0.08* m. Diameter of Vanes (vertical) *0.08* m.
Height of Cairn *0.08* m. Diameter of Cairn *0.08* m. Vanes to *LN* on *Steel Plate* *0.08* m. *LN* on *Steel Plate* *0.08* m. Name Plate *found/placed*.
Length of Mast *0.12* m. (approximate if not unplaced)
 - 0.12* m. *0.08* m. set in conc/rock has been ~~placed~~ ^{found}, bearing *23.14*° M from Mast/Plug/Pillar
 - 0.12* m. set in conc/rock has been placed/found, bearing *23.14*° M from Mast/Plug/Pillar
 - 0.12* m. set in conc/rock has been placed/found, bearing *23.14*° M from Mast/Plug/Pillar
 - 0.12* m. set in conc/rock has been placed/found, bearing *23.14*° M from Mast/Plug/Pillar
- B. Action required:

STANDPOINT:			
Mark	Direction	Horiz. Distance	Height Difference
			above standpt.
			below standpt.
			above standpt.
			below standpt.
Prepared by: *D. J. KAIN*

Checked: *D*

Noted on U.T.M. Card

STATION: *PRESTON'S GEODETIC STATION* No: *2107*
 MAP SHEETS SCALE 1:250 000 *McLINDEN*
 INSPECTED BY: *D. J. KAIN* DATE: *15 JUNE 1984*
 AUTHORITY: *C. M. A.* FIELD BOOK: *1952*

