

CENTRAL MAPPING AUTHORITY

GEODETTIC SURVEY OF N.S.M.K.

GEODETTIC STATION RECONNAISSANCE and MAINTENANCE REPORT

Midkin G.S. — Garah G.S. Traverse. *Recc.*

STATION: GARAH G.S. No.: 2141



MAP SHEET
SCALE 1:250 000 MOREE

INSPECTED BY: D. FREDRIKSEN

DATE: 4/7/79

AUTHORITY: C.M.A.

FIELD BOOK: 1572

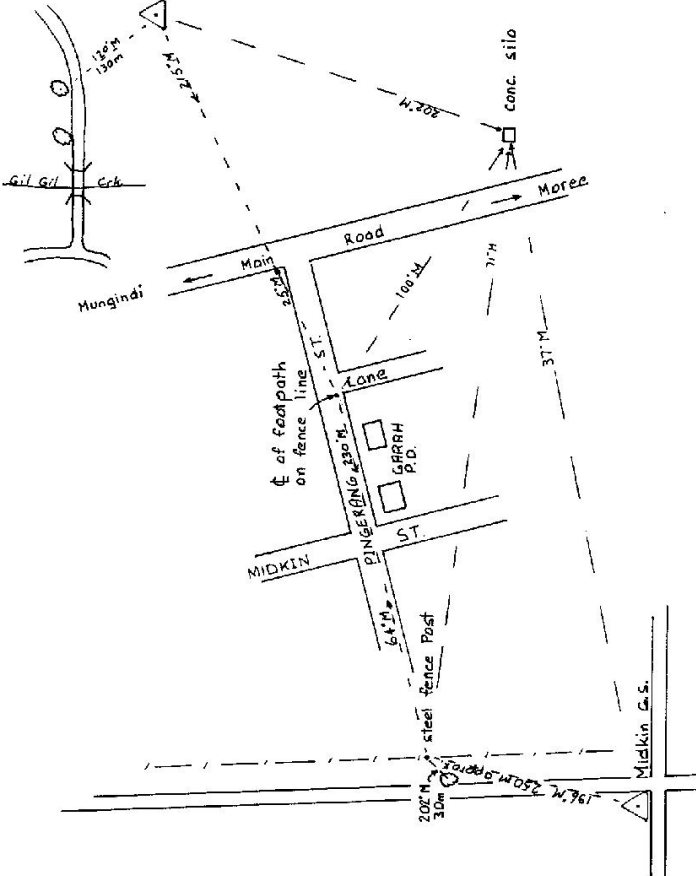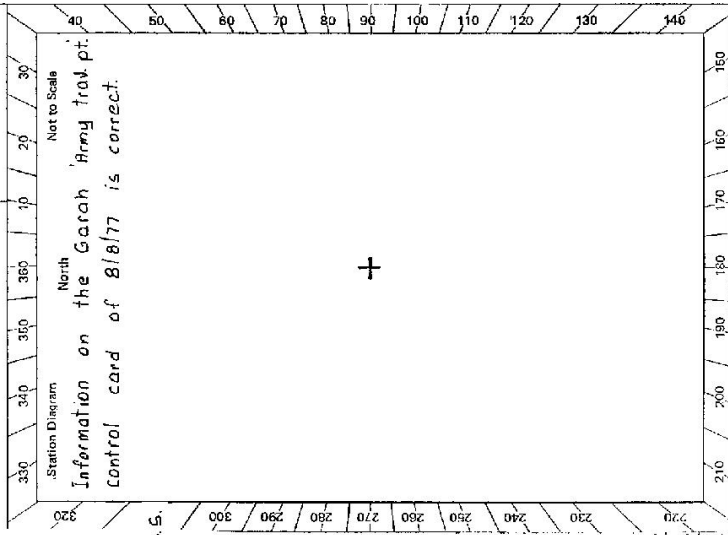

Prepared by: D. FREDRIKSEN 5/9/79 Checked: *DF*

Noted on U.T.M. Card

Checked

S: 2753-1

