

CENTRAL MAPPING AUTHORITY

Department of Lands

Trigonometrical Survey of N.S.W.

RECONNAISSANCE and MAINTENANCE REPORT

This Trig. Station has been:-

Note: Cross out word or words which do not apply

1. Completely cleared to permit 360° vision to surrounding Trigs.
2. Cleared by lanes bearing..... from Trig. Mast
3. Trig. Mast & Vanes have been painted white & black respectively.
4. The Trig. was ~~unpiled~~/not unpiled, dimensions now being: *Original dimensions are a round top and* should be explicit, e.g. Steel plug, Brass plug, Bolt, G.L. Pipe

Description of mark.....

Height of mark.....m above
below rock/concrete.....m above
below G.L.

Height of Top Vanes to Top Mark.....m. Diameter of Vanes (vertical).....m.

Height of Cairn.....m. Diameter of Cairn.....m.

Length of Mast.....m. (approximate if not unpiled)

8. A.....set in conc/rock has been placed.....m. bearing.....°M from Trig. Mast
8. A.....set in conc/soil has been placed.....m. bearing.....°M from Trig. Mast
7. A.....set in conc/soil has been placed.....m. bearing.....°M from Trig. Mast
8. A.....set in conc/rock has been placed.....m. bearing.....°M from Trig. Mast
9. Connection.....to.....m. bearing.....°M
10. Connection.....to.....m. bearing.....°M
11. Connection.....to.....m. bearing.....°M
12. Connection.....to.....m. bearing.....°M
13. Diff. Ht.is.....m. above
below
14. Diff. Ht.is.....m. above
below
15. Diff. Ht.is.....m. above
below
16. Diff. Ht.is.....m. above
below

Prepared by: *g. Hume* 22/12/77 Checked:

Noted on U.T.M. Card

Checked

STATION GATENBY T.S. 2153

Co. Ph:

Map Sheet: N11R1NYA 1:50000 No: 8430-N

Inspected by: J. SHERWIN Date: 11/77

Authority: C.M.A. Field Book: _____

Beacon Diagram Not to Scale

Mast & Vanes
T.S.

Date

Record of Station

 
Address.....

Address.....

Proceed South Along the Newell Highway from Forbes 40 km
At road intersection (Sign 'BIRCHER 41') turn right 5 km to
Websters Road (See Diagram)

Drive to. Suitable Pillar Site.

(On flat plain)



To FORBES
45 km.

Gatenby T.S.

23/2/2005

Apple Double Iron Gates.

List of Observed Directions:—

Standpoint:

Standpoint:

[illegible]

Station

Station

Direction