


ST-2733-2 D. West, Government Printer

Beacon Diagram

Not to Scale

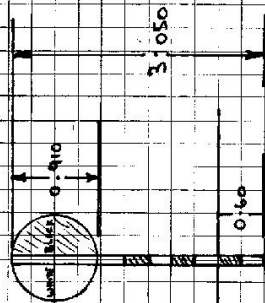

This section to be completed by officer constructing pillar.

Original station mark found/not found.

Description of mark: Round mast with vanes in ground on side of hill

Original beacon found/not found.

Description of beacon: Round mast with vanes in ground on side of hill

Height Top of Vane to Top Mark: 3.050 m.

Height of mark: 0.910 m. above G.L. below

Diameter of Vane: 0.910 m. Most in ground 0.60 m. Height of G.L. 0.60 m.

Original Beacon has/has not been destroyed by me.

STATION GEARYS GAP TS 2155

Owner's Name: NOT KNOWN

Address:

Phone:

Current Occupant:

Address:

Phone:

ACCESS

Access Report of 5.1.12/1978 was found suitable/unsuitable.

From Collector Post Office 0.00m, Travel southward along Federal Highway
 0.00 km.
 0.50
 1.50
 15.00
 19.90

Crossing Collector bridge at:

passing Gunning Inn off on R.H.S.

past rest area

to rest area - Garry's Gap Trig

at:-

at:-


at:-

at:-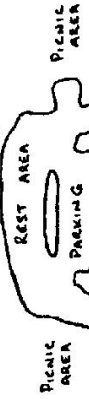

COLLECTOR

CANBERRA

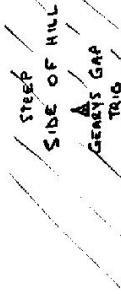

Not a good site for a pillar

Record of Station

Date