

GEODETTIC SURVEY OF NS&K

CENTRAL MAPPING AUTHORITY

GEODETTIC STATION RECONNAISSANCE and MAINTENANCE REPORT

STATION: **Geelooma G.S.** No.: **2157**  
 MAP SHEET SCALE 1:250 000 **Capeallingo**  
 INSPECTED BY: **J.W. Robins** DATE: **11/1/78**  
 AUTHORITY: **CMA** FIELD BOOK:

Station Diagram  
 North  
 Not to Scale

- Description:  
 1. Cleared by lanes bearing **360°**. Note: Cross out word or words which do not apply  
 2. Mast & Vanes have been painted white & black respectively.  
 3. The station/~~pillar~~ was ~~erected~~/not unplied/~~constructed on~~ **10** m. ~~dimensions new being:~~  
 Description of mark.....should be explicit, e.g., S/Steel Pillar Plate, Steel plug, Brass plug, Bolt, G.I. Pipe  
 Height of mark.....m. <sup>above</sup>/<sub>below</sub> rock/concrete; Mark is.....m. <sup>above</sup>/<sub>below</sub> G.L.  
 Height of Top Vanes to Top Mark/Pillar plate .....m. Diameter of Vanes (vertical).....**0.73**m.  
 Height of Cairn.....**2.2**m. Diameter of Cairn.....m. Name Plate found/not found/placed.  
 Length of Mast.....**4.25**m. (approximate if not unplied)
4. A.....set in conc/rock has been placed/found, bearing.....°M from Mast/Plug/Pillar  
 5. A.....set in conc/rock has been placed/found, bearing.....°M from Mast/Plug/Pillar  
 6. A.....set in conc/rock has been placed/found, bearing.....°M from Mast/Plug/Pillar  
 7. A.....set in conc/rock has been placed/found, bearing.....°M from Mast/Plug/Pillar  
 8. Action required: **Station is sited on top of a large wooden suitable for pillar.**

STANDPOINT:

Mark	Direction	Horiz. Distance	Height Difference	Mark	Direction	Horiz. Distance	Height Difference
			above standpt.				above standpt.
			below standpt.				below standpt.
			above standpt.				above standpt.
			below standpt.				below standpt.
			above standpt.				above standpt.
			below standpt.				below standpt.
			above standpt.				above standpt.
			below standpt.				below standpt.


Prepared by: **J.W. Robins 7.5 3/4/78** Checked: **Checked**  
 Noted on U.T.M. Card

STATION  
**GEELOOMA G.S. 2157**


Owner's Name: .....  
 Address: .....  
 Phone: .....

Current Occupant: .....  
 Address: .....  
 Phone: .....

Phone: 11/11/1978  
 ACCESS 11/11/1978  
 To Lake Cargelligo - Ungarie Road 18km  
 Lake Cargelligo 63km  
 Fullibrigal 24km  
 Access Report of 11/11/1978 was found suitable for transit etc.

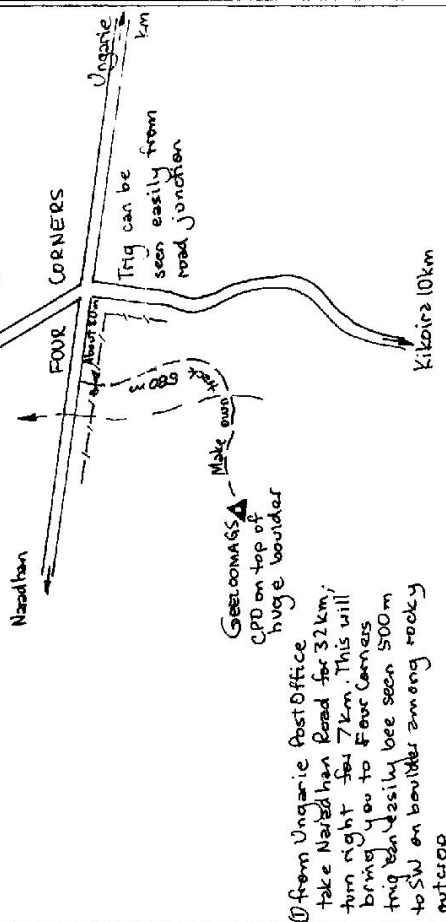

① From Ungarie Post Office  
 take Nardhan Road for 32 km,  
 turn right for 7 km. This will  
 bring you to Four Corners  
 trig can easily be seen 500 m  
 to SW on boulder among rocky  
 outcrop

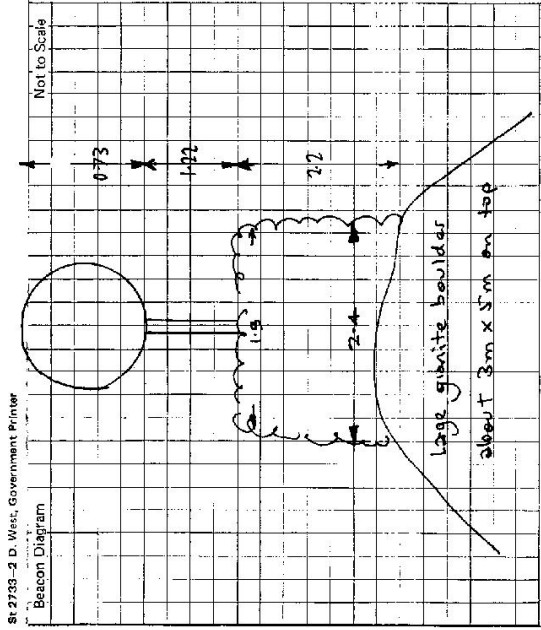

St 2157-3 D. West, Government Printer  
 Beacon Diagram

This section to be completed by officer constructing pillar.

Original station mark found/not found. ....

Description of mark: .....

Original beacon found/not found. ....

Description of beacon: .....

Height Top of Vanes to Top Mark .....m.

Height of mark .....m. above G.L. below

Diameter of Vanes .....m. Height of Cairn .....m.

Original Beacon has/has not been destroyed by me.

Date .....

Record of Station .....