

GEODETTIC SURVEY OF M.S.W.

CENTRAL MAPPING AUTHORITY

GEODETTIC STATION RECONNAISSANCE and MAINTENANCE REPORT


STATION: GENOE G.S.	TS No.: 2160
MAP SHEET SCALE 1:250 000 SWAN HILL	TDP-#BUC 1:50,000
INSPECTED BY: R. COOK	DATE: 20-11-78
AUTHORITY:	FIELD BOOK:

Description:
 Note: Cross out word or words which do not apply

1. Cleared by lanes bearing..... from Trig, Mast
2. Mast & Vanes have been painted white & black respectively.
3. The station/pillar was unpiled/not unpiled/constructed on..... 19....., dimensions now being:
 Description of mark.....should be explicit, e.g., S/Steel Pillar Plate, Steel plug, Brass plug, Bolt, G.I. Pipe
 Height of mark.....m. ^{above} rock/concrete; Mark is.....m. ^{above} G.L.
 Height of Top Vanes to Top Mark/Pillar platem. Diameter of Vanes (vertical).....m.
 Height of Cairn.....m. Diameter of Cairn.....m. Name Plate found/not found/placed.
 Length of Mastm. (approximate if not unpiled)
4. A.....set in conc/rock has been placed/found, bearing.....° M from Mast/Plug/Pillar
5. A.....set in conc/rock has been placed/found, bearing.....° M from Mast/Plug/Pillar
6. A.....set in conc/rock has been placed/found, bearing.....° M from Mast/Plug/Pillar
7. A.....set in conc/rock has been placed/found, bearing.....° M from Mast/Plug/Pillar
8. Action required:.....

STANDPOINT:			
Mark	Direction	Horiz. Distance	Height Difference
			above standpt.
			below
			above standpt.
			below
Prepared by: *Rodney Cook* Checked: _____
 Noted on U.T.M. Card

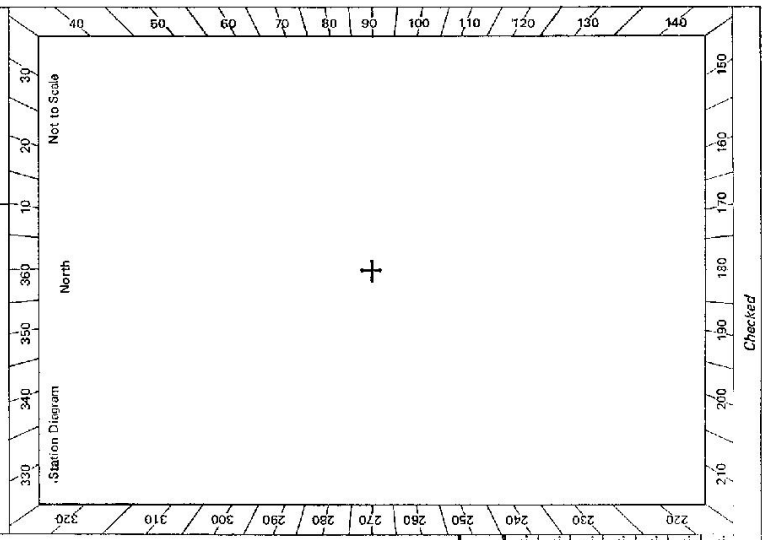

GS 24

<p style="font-size: small;">St 2733-2 D. West, Government Printer</p> <p style="font-size: small;">Beacon Diagram</p>	Not to Scale	STATION	<p style="font-size: large; font-weight: bold;">GENOE G.S. TS 2160</p>
<p>Owner's Name:</p> <p>Address:</p> <p>Phone:</p>		<p>Current Occupant:</p> <p>Address:</p> <p>Phone:</p>	<p>ACCESS</p> <p>Access Report of 20/11/1978 was found suitable/unsuitable.</p>
<p style="font-size: small;">Access Taken from the Tooleybuc 1:50,000 sheet</p>			
<p>Date: 30-11-78</p> <p>Record of Station: ONLY GUARDRAIL STANDING. NO VANES FOUND IS LAMINATE OVER ONE POLYMER NO CLEARANCE REQUIRED</p>			
<p>This section to be completed by officer constructing pillar.</p> <p>Original station mark found/not found.</p> <p>Description of mark:</p> <p>Original beacon found/not found.</p> <p>Description of beacon:</p> <p>Height Top of Vanes to Top Mark.....m.</p> <p>Height of mark.....m. above rock/cons.....m. below G.L.</p> <p>Diameter of Vanes.....m. Height of Cairn.....m.</p> <p>Original Beacon has/has not been destroyed by me.</p>			